


2/S001 STRUCTURE

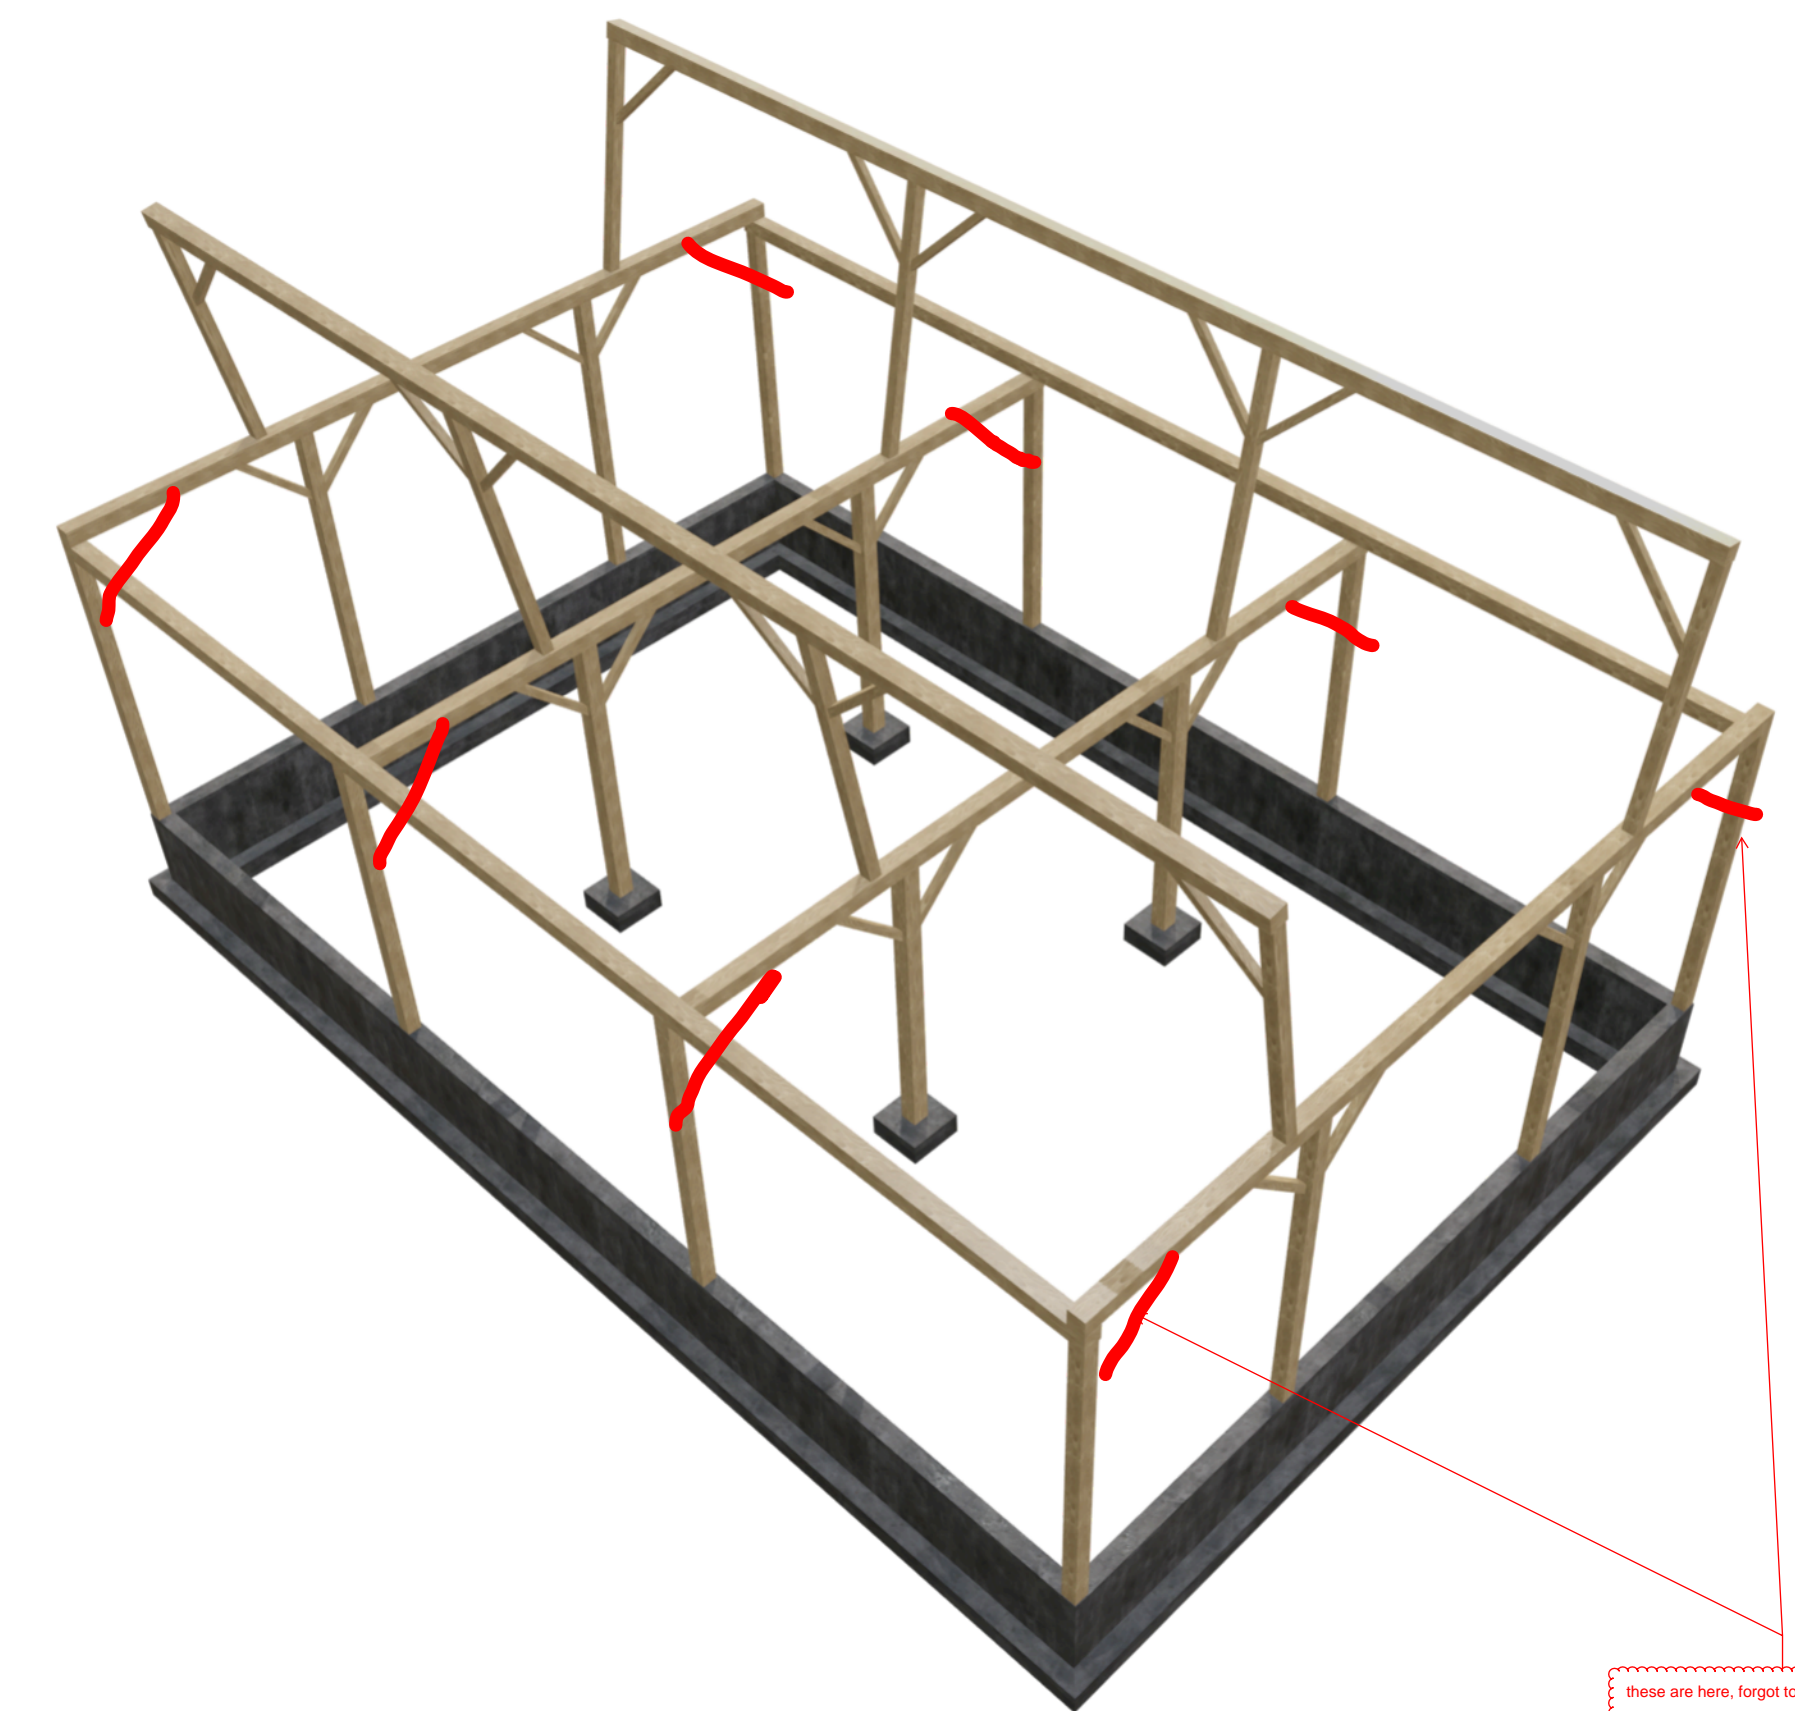

1/S001 FOUNDATION PLAN
1/4"=1'-0"

RYAN - DO YOU THINK WE SHOULD ADD STOOP WALLS AND FOOTINGS AT THE EXTERIOR DOORS?

LET ME KNOW WHAT THEY POURED. IF THE WALL FOOTING WIDTH IS +/- 20" WE WOULD NOT NEED TO CUT IT OUT TO ADD SOME FOOTINGS AT THE POSTS.

footings currently buried... I have a question to the concrete sub to get specs on what they poured.

FOOTING SCHEDULE 2000 PSF BEARING		
MARK NO	SIZE	REINFORCING
F1	3'-0" x 3'-0" x 12"	4 - #4 BARS EACH WAY
F2	4'-6" x 4'-6" x 12"	4 - #5 BARS EACH WAY



Owner: Kenlyn/Marquis German Shepherd Dogs
11714 N Eastman Rd
Edgerton, WI 53534-9051
Kentboylesgsd@aol.com | 608.884.8355

Structural: Ennovation
PO Box 148
Orfordville, WI 53576
ktrey@ennovationbuilt.com | 608.212.6998

Architect: Opening Design
17 S Fairchild | FL 7
Madison, WI 53703
ryan@openingdesign.com | 773.425.6456

FOUNDATION PLAN
BARN RELOCATION

389 E HEMENWAY LANE - EDGERTON, WI 53534

S001

This project, like most OpeningDesign's projects, is open source (Attribution-ShareAlike 4.0 International=CC-BY-SA 4.0) - freely available to any party for future use, assuming the terms such as Attribution and ShareAlike are honored.