

SEWER

16849

Application No.

RECORD

WATER

16849

Application No.

OF SEWER AND WATER SERVICE CONNECTION

Permit No.

9407

Record No.

JANESVILLE, WISCONSIN

Permit No.

Record No.

At House No. 1600 on W side of CENTER Ave. Ave. Ave.
 Between St. and St. St.

Situated on UNPLATTED
 For GLEN JONES 139-168.4-211.4 owner from Y feet N of Manhole
 at


Remarks

LOCATION		SEWER				WATER			
From	To	Size	Kind	Date	Laid By	Size	Kind	Date	Laid By
Main	Curb	4"	CI	10/	McVicar	3/4"	COP	10/	McVicar
Curb	Lot Line	"	"	30/	P+H	"	"	30/	P+H
Lot Line	House Drain	"	"	58	Co.	"	"	58	Co.

Inspected by 19.....

Located by 19.....

Stop Box to Curb to Walk to Local Objects

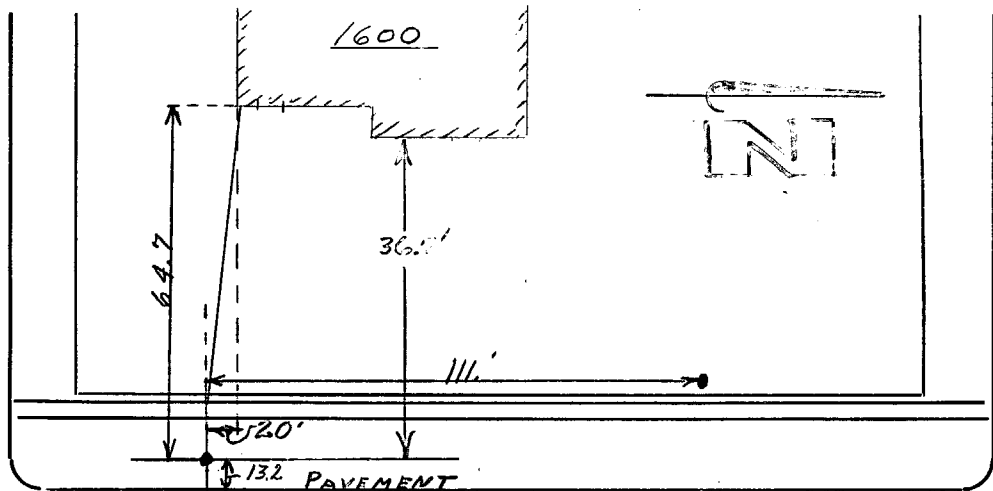

CENTER AVE.