


1/A001 LIFE SAFETY PLAN - 1ST FLOOR
1/8"=1'-0"

NUMBER	NAME	AREA	FUNCTION OF SPACE	AREA PER OCCUPANT	OCCUPANTS	OCCUPANCY TYPE
100	LOBBY & OPEN OFFICE	290	BUSINESS AREA	100	2.9	(B) OCCUPANCY
102	OFFICE - LARGE	162	BUSINESS AREA	100	1.6	(B) OCCUPANCY
103	DELIVERY BAY	387	INDUSTRIAL AREAS	100	3.9	(S-1) OCCUPANCY
104	RESTROOM	62	CIRCULATION	0	0	(B) OCCUPANCY
105	RESTROOM	62	CIRCULATION	0	0	(B) OCCUPANCY
106	SERVICE OFFICE	154	BUSINESS AREA	100	1.5	(B) OCCUPANCY
107	CORRIDOR	380	CIRCULATION	0	0	(B) OCCUPANCY
108	WAITING AREA	113	ASSEMBLY - UNCONCENTRATED	15	7.5	(B) OCCUPANCY
109	SERVICE DESK	128	BUSINESS AREA	100	1.3	(B) OCCUPANCY
110	STAIR	83	CIRCULATION	0	0	(B) OCCUPANCY
111	SERVICE AREA	2334	INDUSTRIAL AREAS	100	23.3	(S-1) OCCUPANCY
112	FENCED IN AREA	297	STORAGE	300	1	(B) OCCUPANCY
		1st Floor SF	4452	Sum - 1st Floor	43	
200	CORRIDOR	140	CIRCULATION	0	0	(B) OCCUPANCY
201	OFFICE	179	BUSINESS AREA	100	1.8	(B) OCCUPANCY
202	RESTROOM	65	CIRCULATION	0	0	(B) OCCUPANCY
203	OFFICE	124	BUSINESS AREA	100	1.2	(B) OCCUPANCY
204	OFFICE	155	BUSINESS AREA	100	1.6	(B) OCCUPANCY
205	OFFICE	146	BUSINESS AREA	100	1.5	(B) OCCUPANCY
206	MECH.	50	STORAGE	300	0.2	(B) OCCUPANCY
		2nd Floor SF	859	Sum - 2nd Floor	6.3	
		Total SF	5311	Sum - All Floors	49	


3/A001 ROOM SCHEDULE - OCCUPANCY

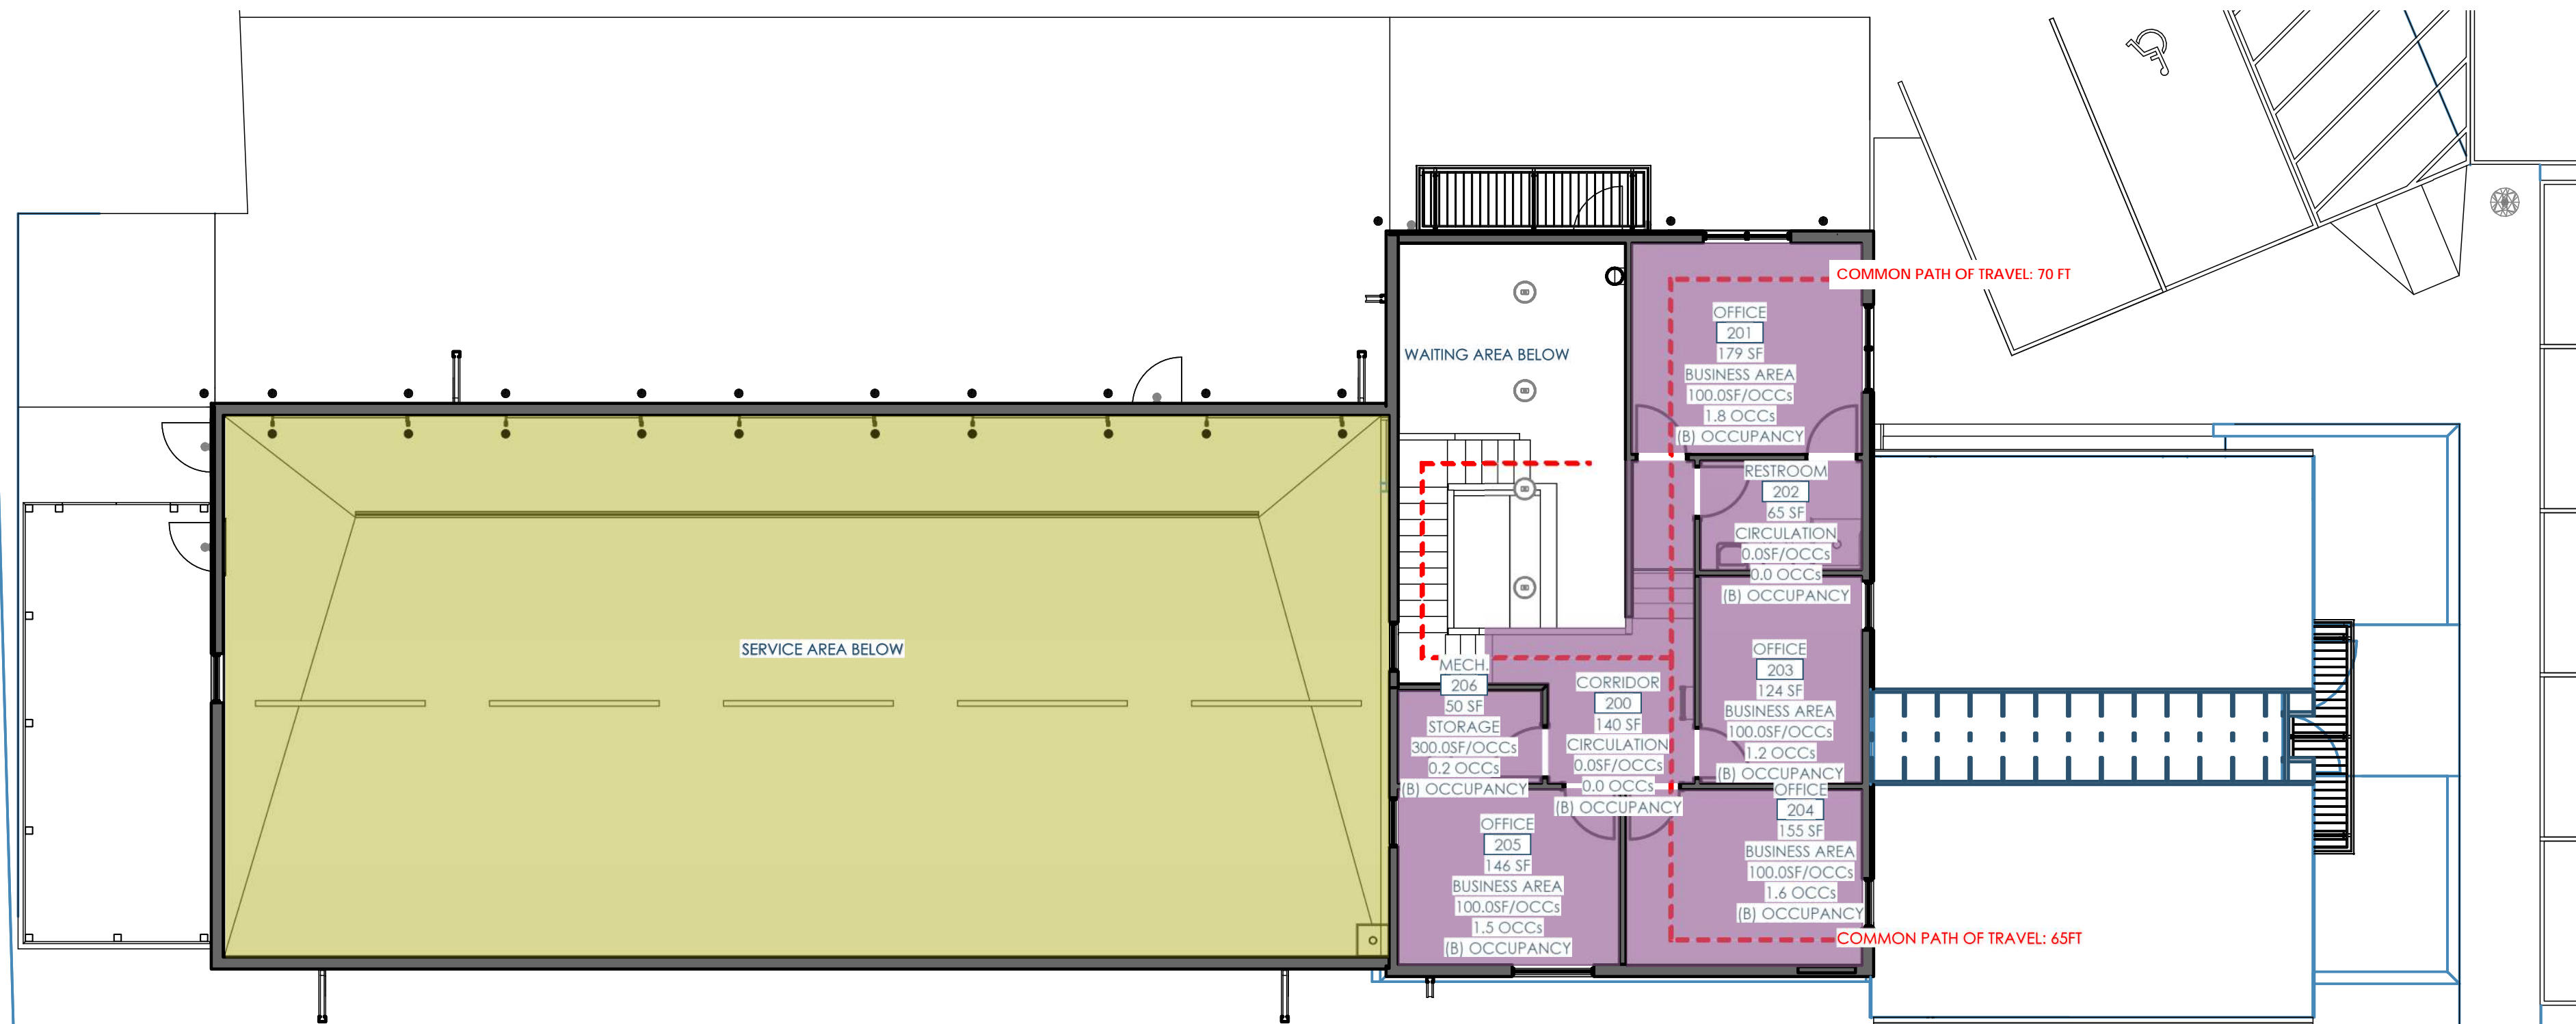

3/A001 LIFE SAFETY PLAN - MEZZANINE
1/8"=1'-0"



This project, like most Opening Design's projects, is open source (Attribution-ShareAlike 4.0 International-CC BY-SA 4.0)-freely available to any party for future use, assuming the terms such as Attribution and ShareAlike are honored.

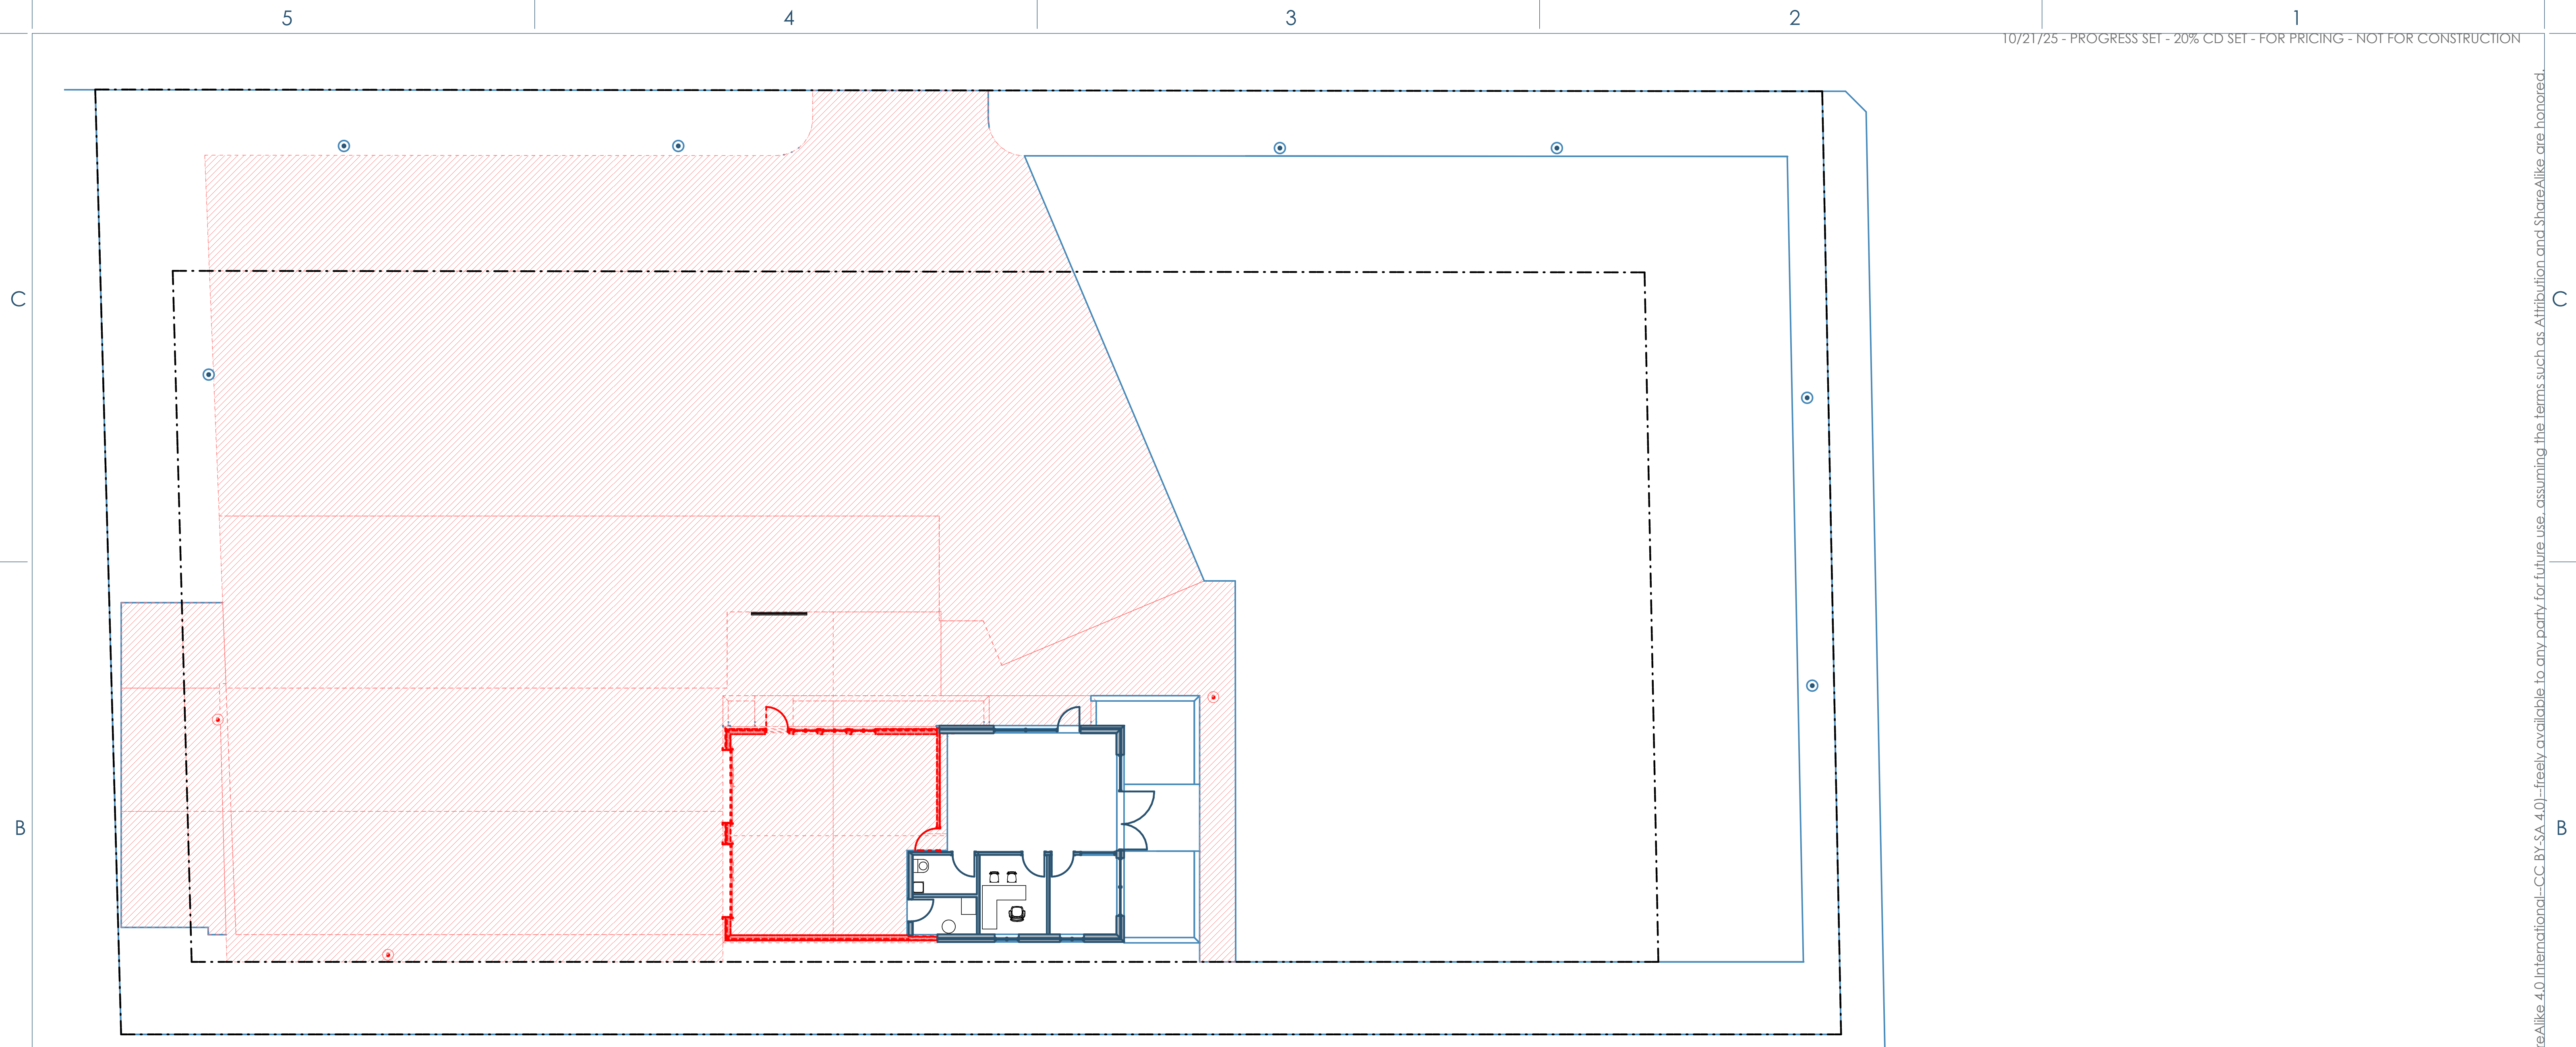

5B/A050 PHASE 1 - DEMOLITION PLAN
3/32"=1'-0"



Owner: Cool Car Guys
1600 Center Ave
Janesville, WI 53546
608.531.1600



GC: Lake Country Construction Group
161 Horizon Dr
Verona, WI 53593
608.845.1398




Architect: Opening Design
17 S Fairchild | FL 7
Madison, WI 53703
ryan@openingdesign.com | 773.425.6456

DEMOLITION PLANS - 1ST PHASE
COOL CAR GUYS
1600 CENTER AVE, JANESVILLE, WI 53546

A050

This project, like most Opening Design's projects, is open source (Attribution-ShareAlike 4.0 International=CC BY-SA 4.0) - freely available to any party for future use, assuming the terms such as Attribution and ShareAlike are honored.

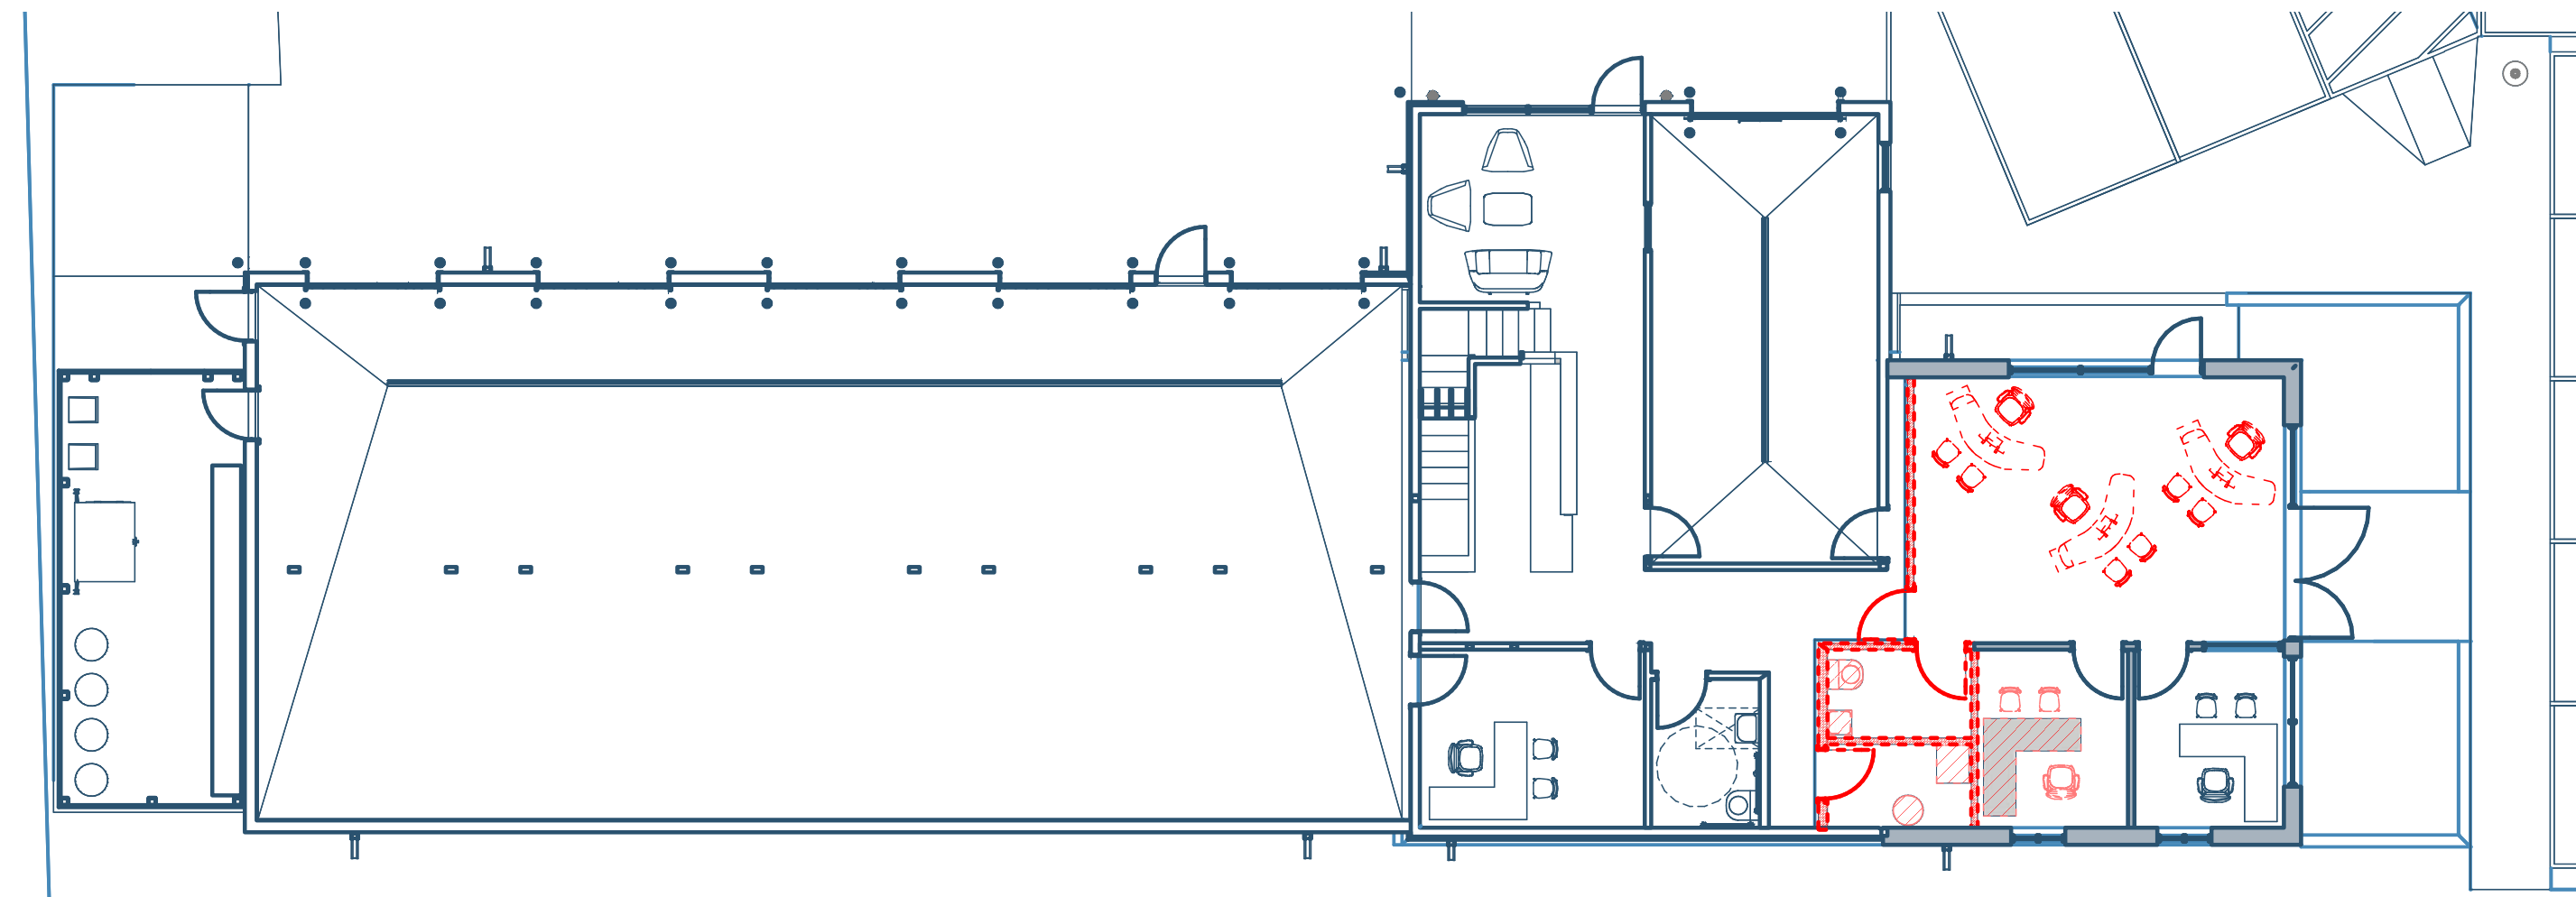

1/A051 PHASE 2 - DEMOLITION PLAN
3/32"=1'-0"



Owner: Cool Car Guys
1600 Center Ave
Janesville, WI 53546
608.531.1600



GC: Lake Country Construction Group
161 Horizon Dr
Verona, WI 53593
608.845.1398



Architect: Opening Design
17 S Fairchild | FL 7
Madison, WI 53703
ryan@openingdesign.com | 773.425.6456

DEMOLITION PLANS - 2ND PHASE
COOL CAR GUYS
1600 CENTER AVE, JANESVILLE, WI 53546

A051

This project, like most Opening Design's projects, is open source (Attribution-ShareAlike 4.0 International=CC BY-SA 4.0) - freely available to any party for future use, assuming the terms such as Attribution and ShareAlike are honored.

5

4

3


2

1

C

B

A

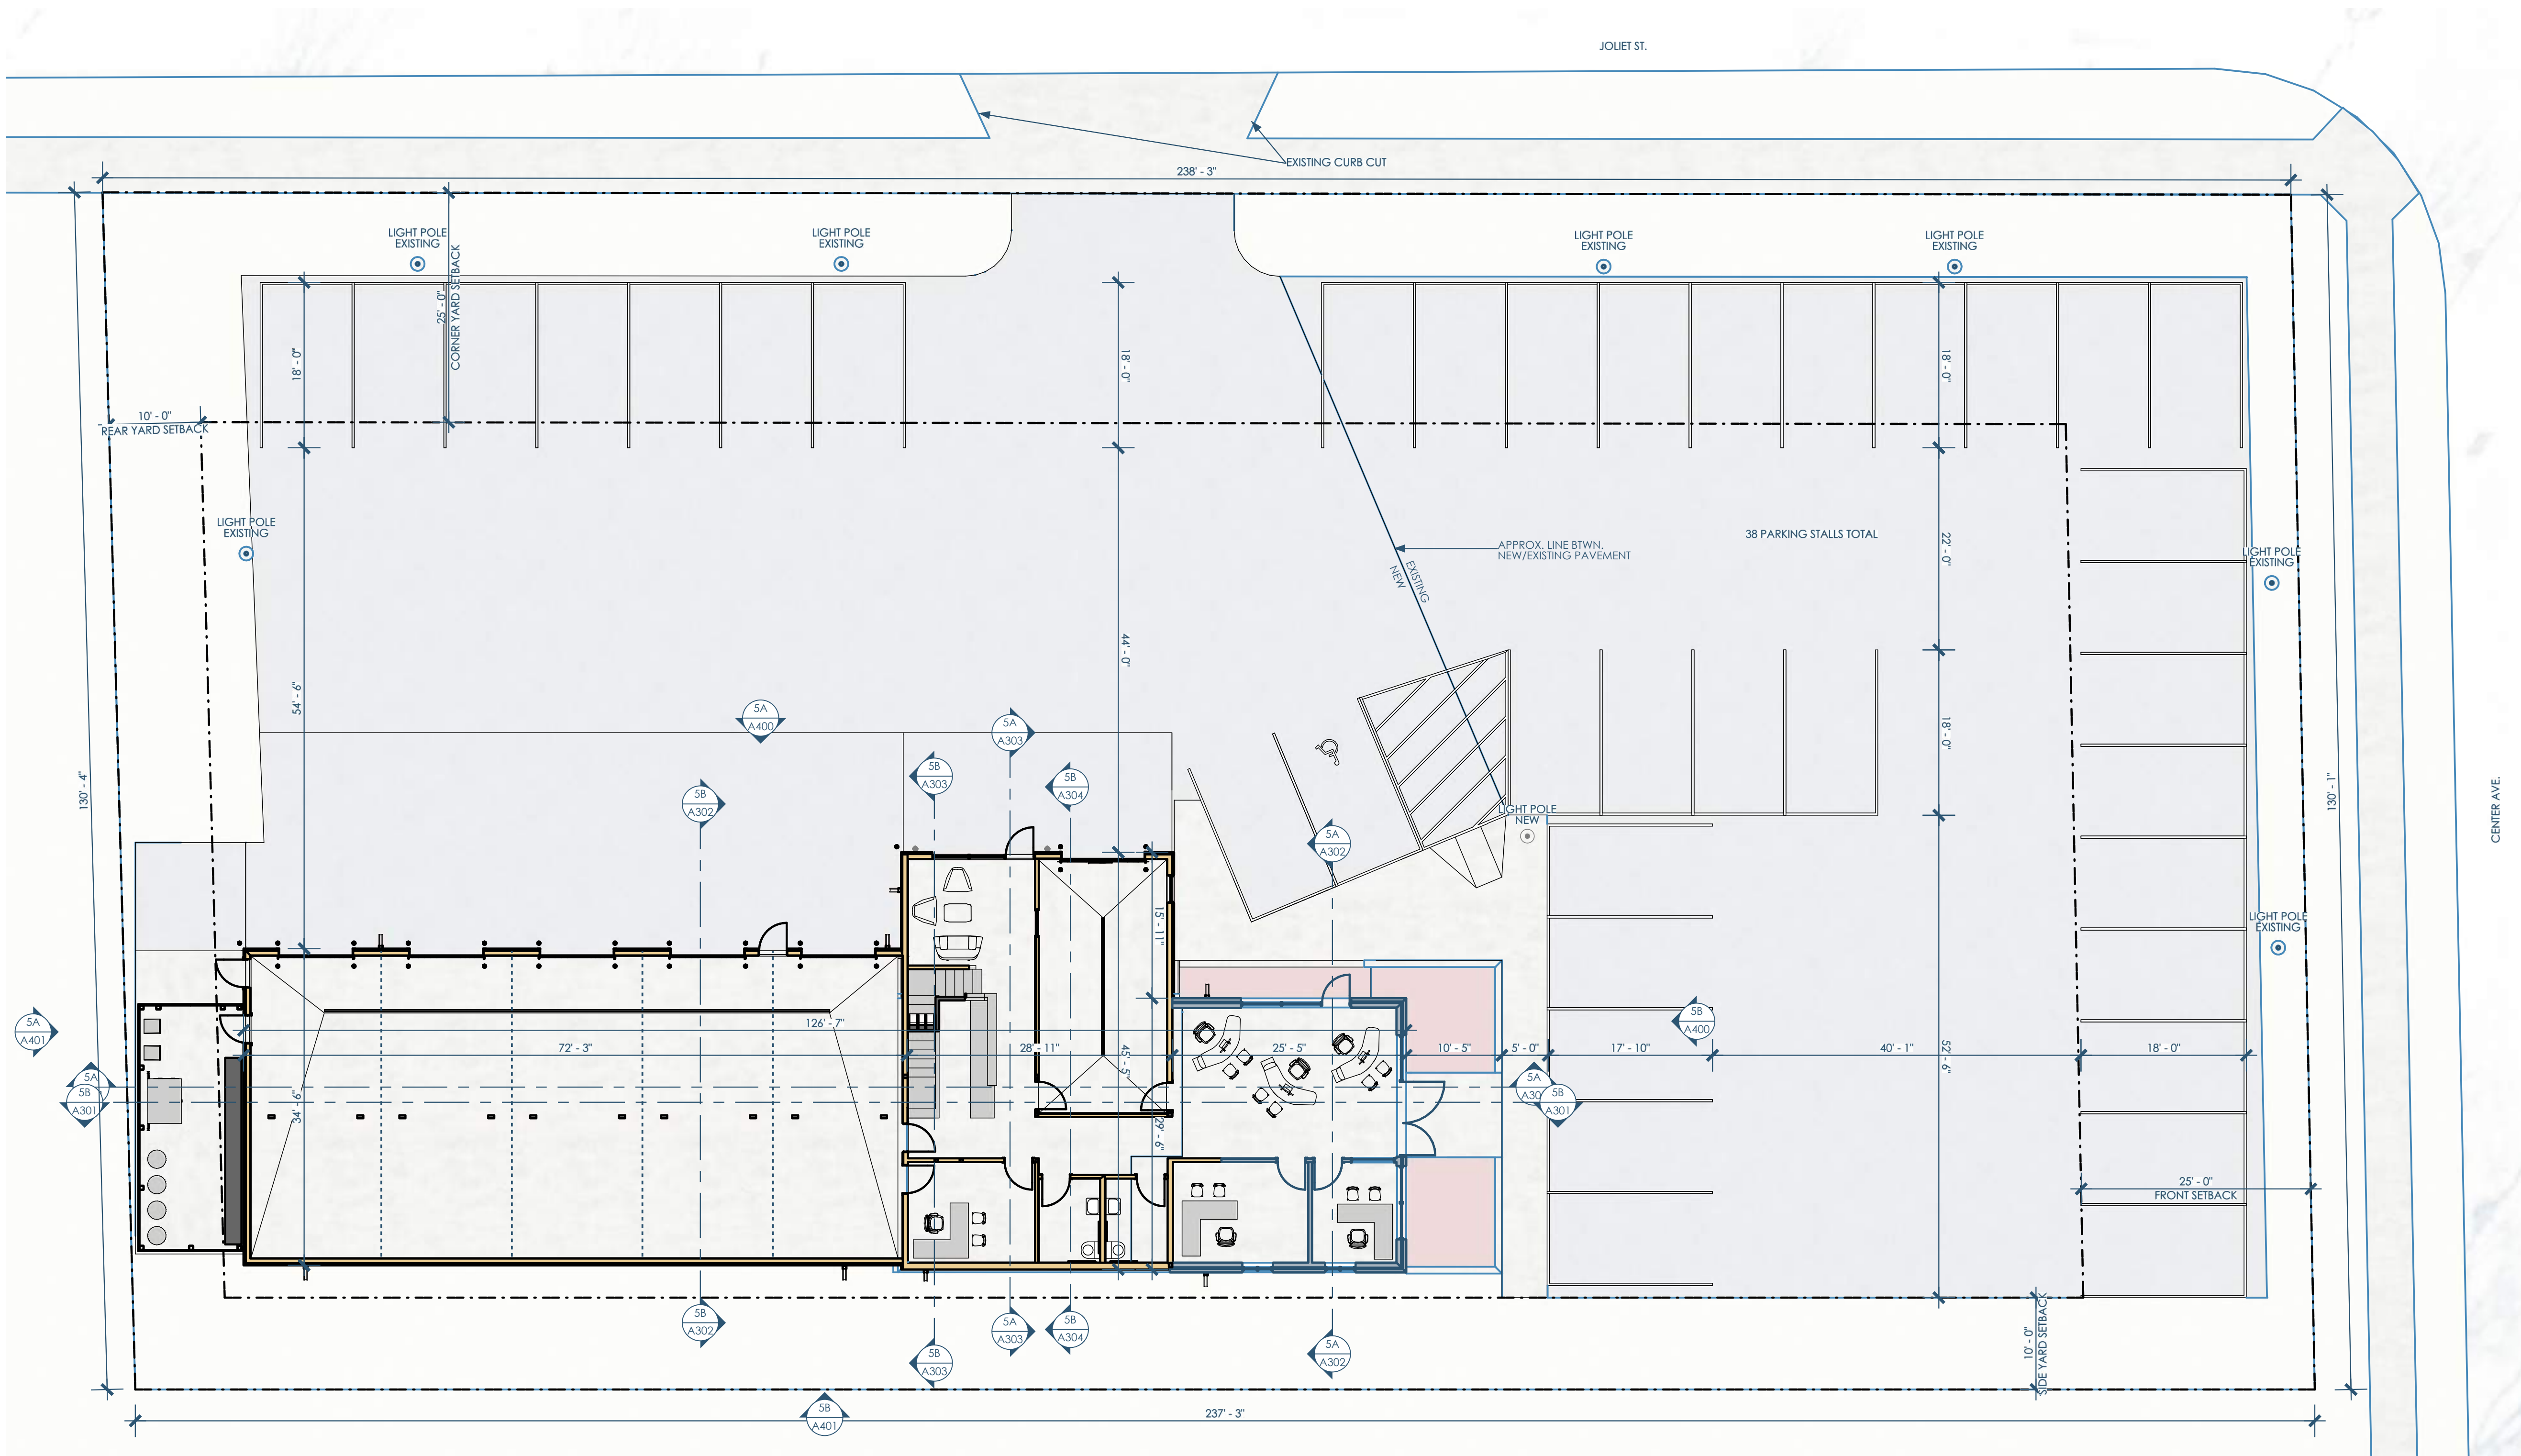

5A/A100 SITE PLAN
1"=10'



Owner: Cool Car Guys
1600 Center Ave
Janesville, WI 53546
608.531.1600

GC: Lake Country Construction Group
161 Horizon Dr
Verona, WI 53593
608.845.1398

Architect: Opening Design
17 S Fairchild | FL 7
Madison, WI 53703
ryan@openingdesign.com | 773.425.6456

SITE PLAN
COOL CAR GUYS
1600 CENTER AVE, JANESVILLE, WI 53546

A100

5


4

3

2

1

This project, like most Opening Design's projects, is open source (Attribution-ShareAlike 4.0 International=CC BY-SA 4.0) - freely available to any party for future use, assuming the terms such as Attribution and ShareAlike are honored.

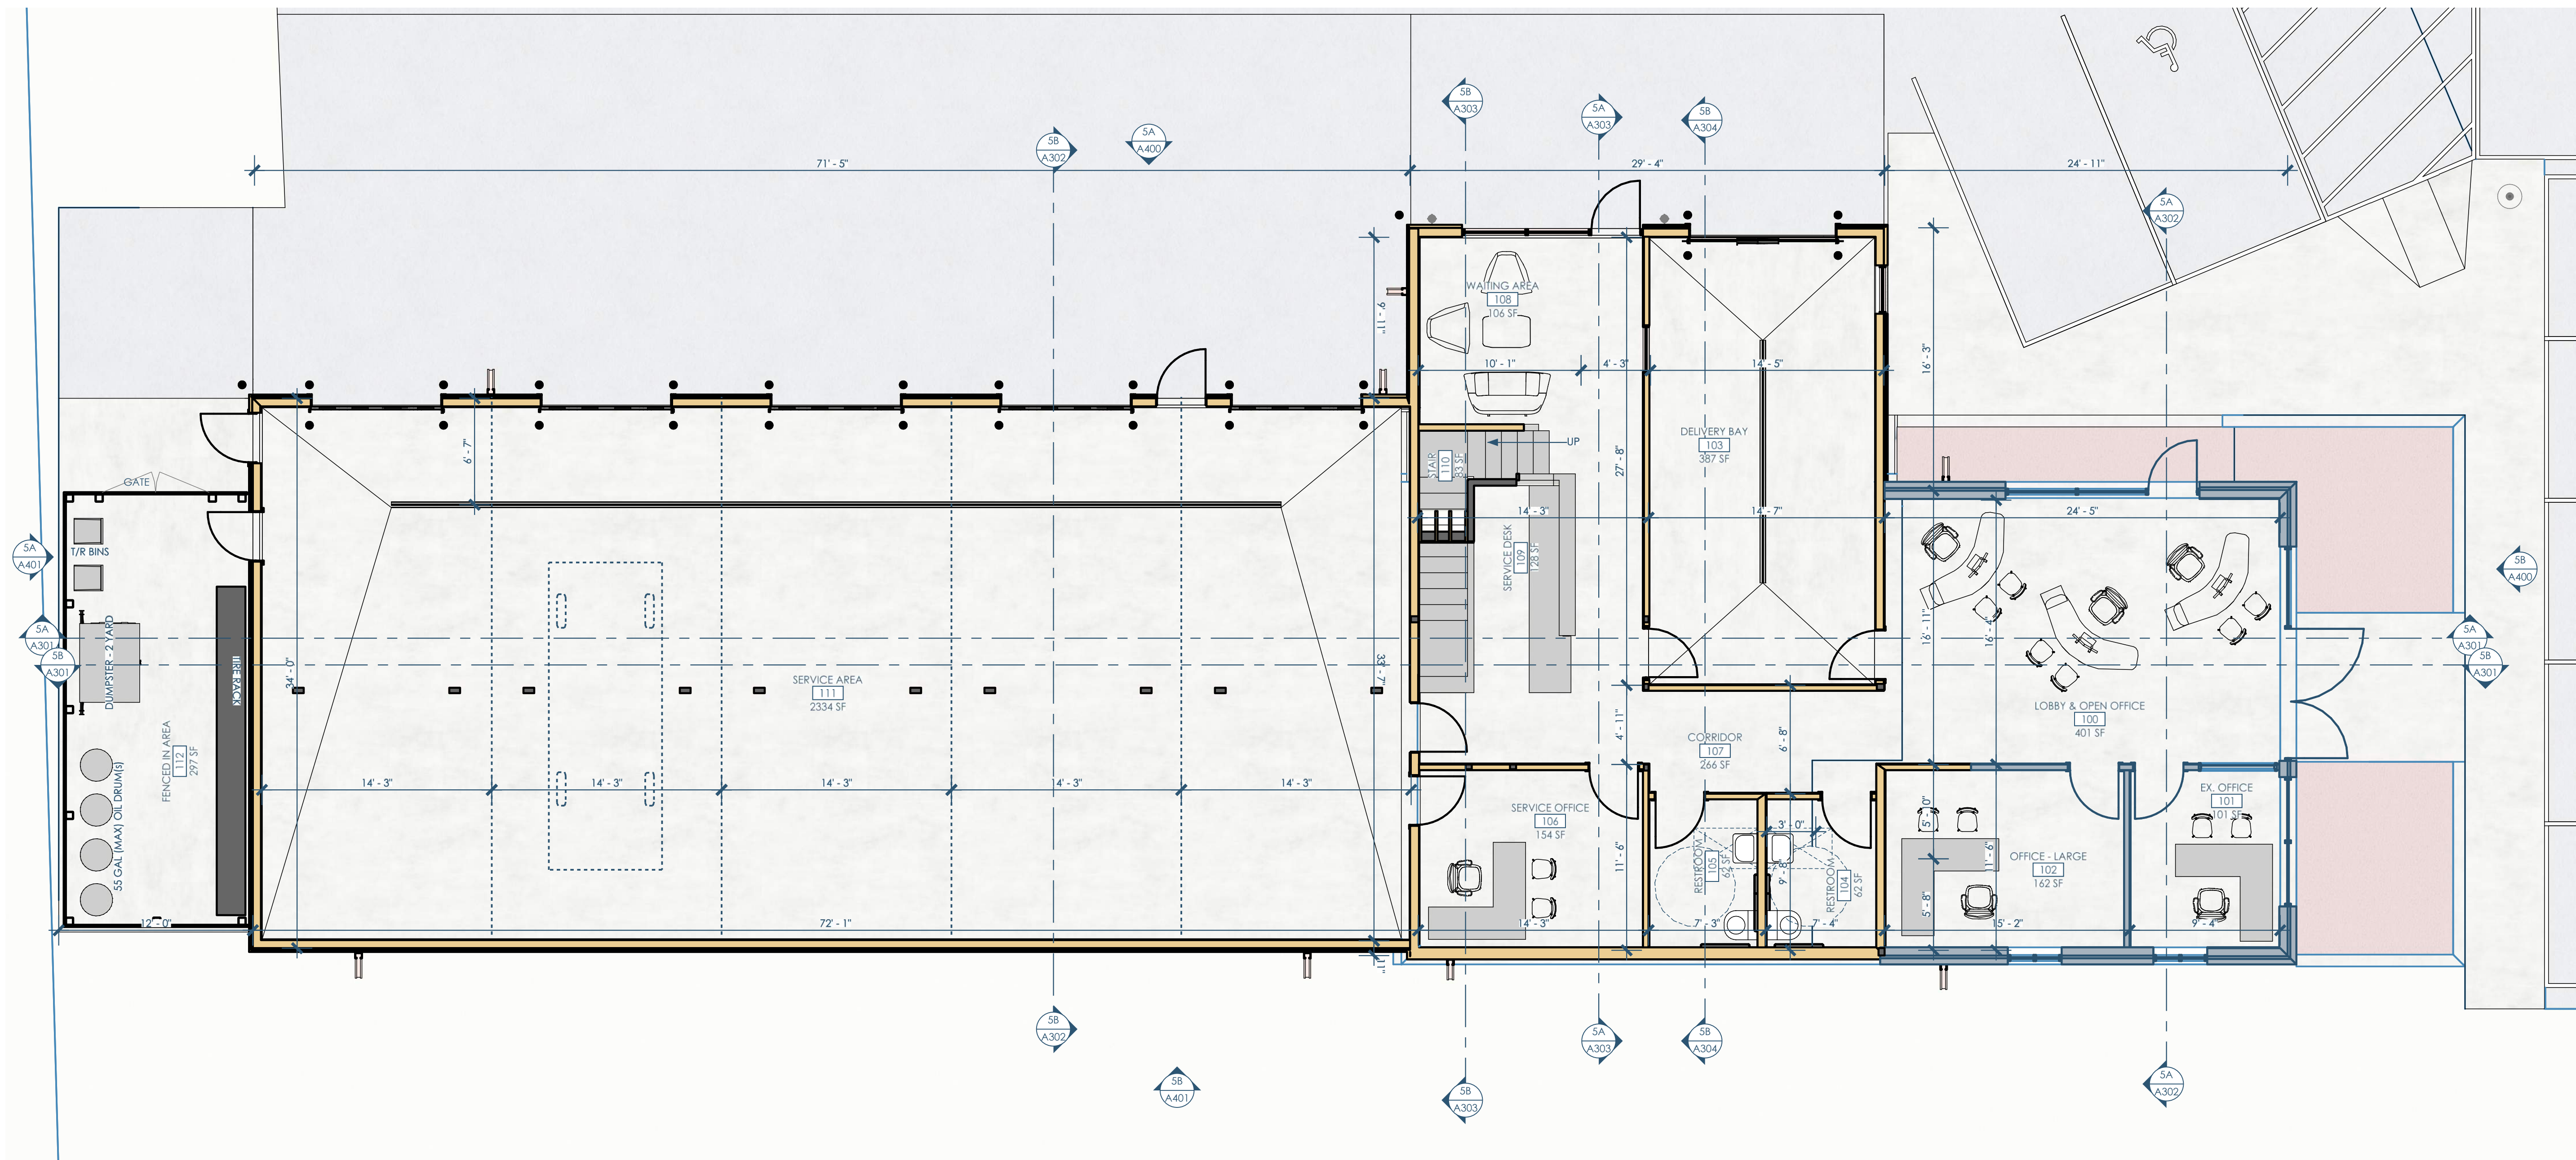

5B/A101 PHASE 2 - 1ST FLOOR
3/16"=1'-0"



Owner: Cool Car Guys
1600 Center Ave
Janesville, WI 53546
608.531.1600



GC: Lake Country Construction Group
161 Horizon Dr
Verona, WI 53593
608.845.1398




Architect: Opening Design
17 S Fairchild | FL 7
Madison, WI 53703
ryan@openingdesign.com | 773.425.6456

PHASE 2 - FIRST FLOOR
COOL CAR GUYS

1600 CENTER AVE, JANESVILLE, WI 53546

A101_2

This project, like most Opening Design's projects, is open source (Attribution-ShareAlike 4.0 International--CC BY-SA 4.0)--freely available to any party for future use...assuming the terms such as Attribution and ShareAlike are honored.

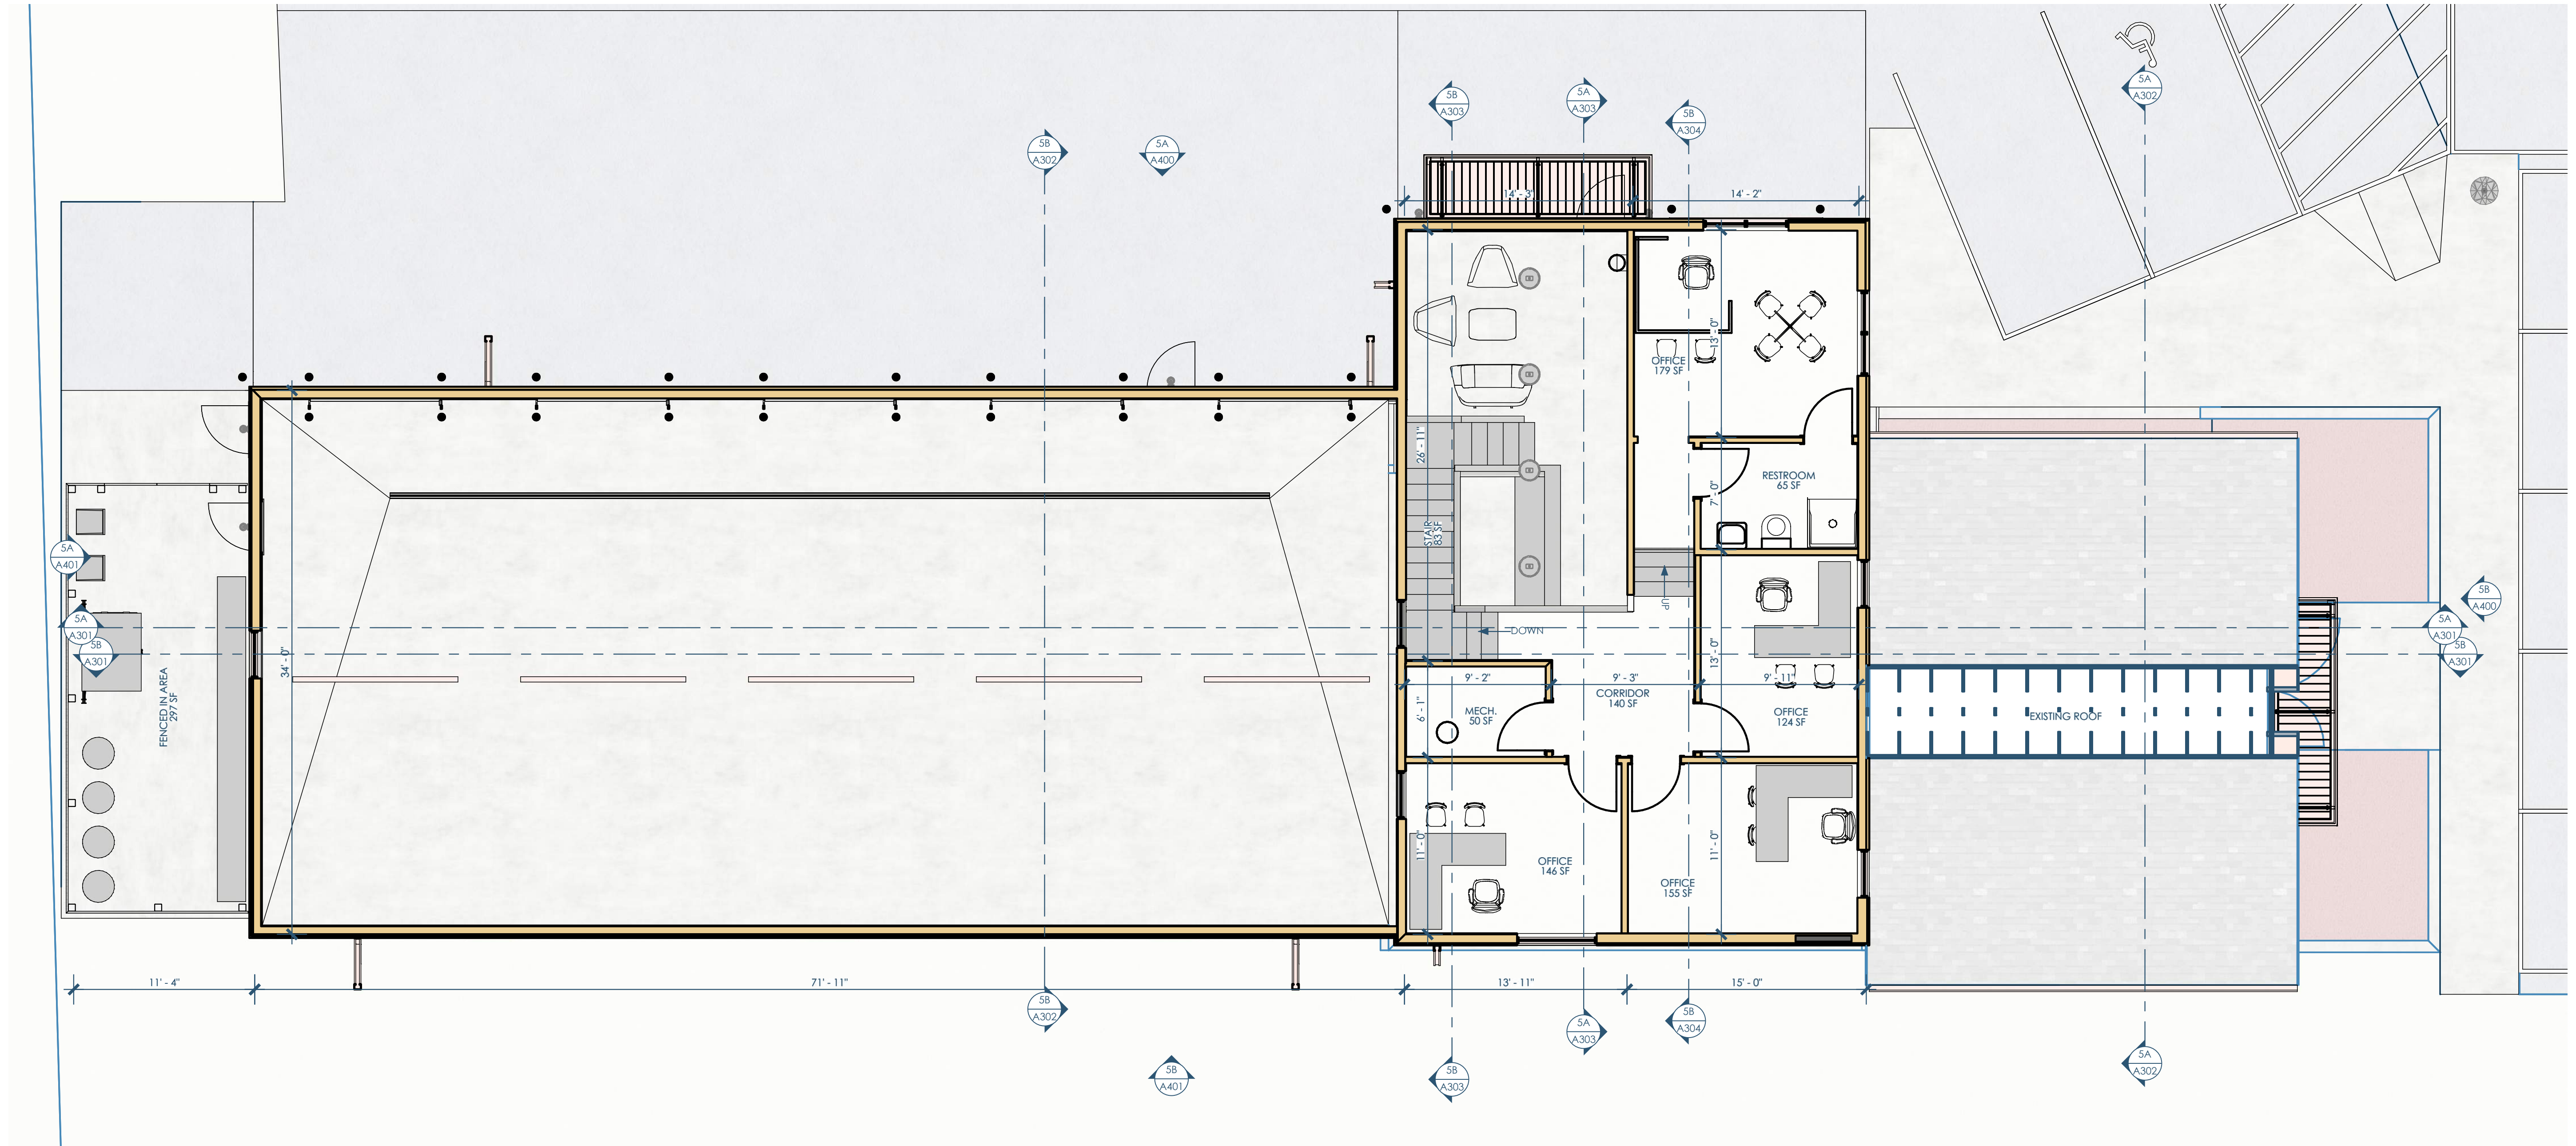

5B/A102 PHASE 2 - MEZZ 3/16"=1'-0"



Owner: Cool Car Guys
1600 Center Ave
Janesville, WI 53546
608.531.1600



GC: Lake Country Construction Group
161 Horizon Dr
Verona, WI 53593
608.845.1398




Architect: Opening Design
17 S Fairchild | FL 7
Madison, WI 53703
ryan@openingdesign.com | 773.425.6456

PHASE 2 - MEZZANINE
COOL CAR GUYS

1600 CENTER AVE, JANESVILLE, WI 53546

A102

This project, like most Opening Design's projects, is open source (Attribution-ShareAlike 4.0 International=CC BY-SA 4.0) - freely available to any party for future use... assuming the terms such as Attribution and ShareAlike are honored.

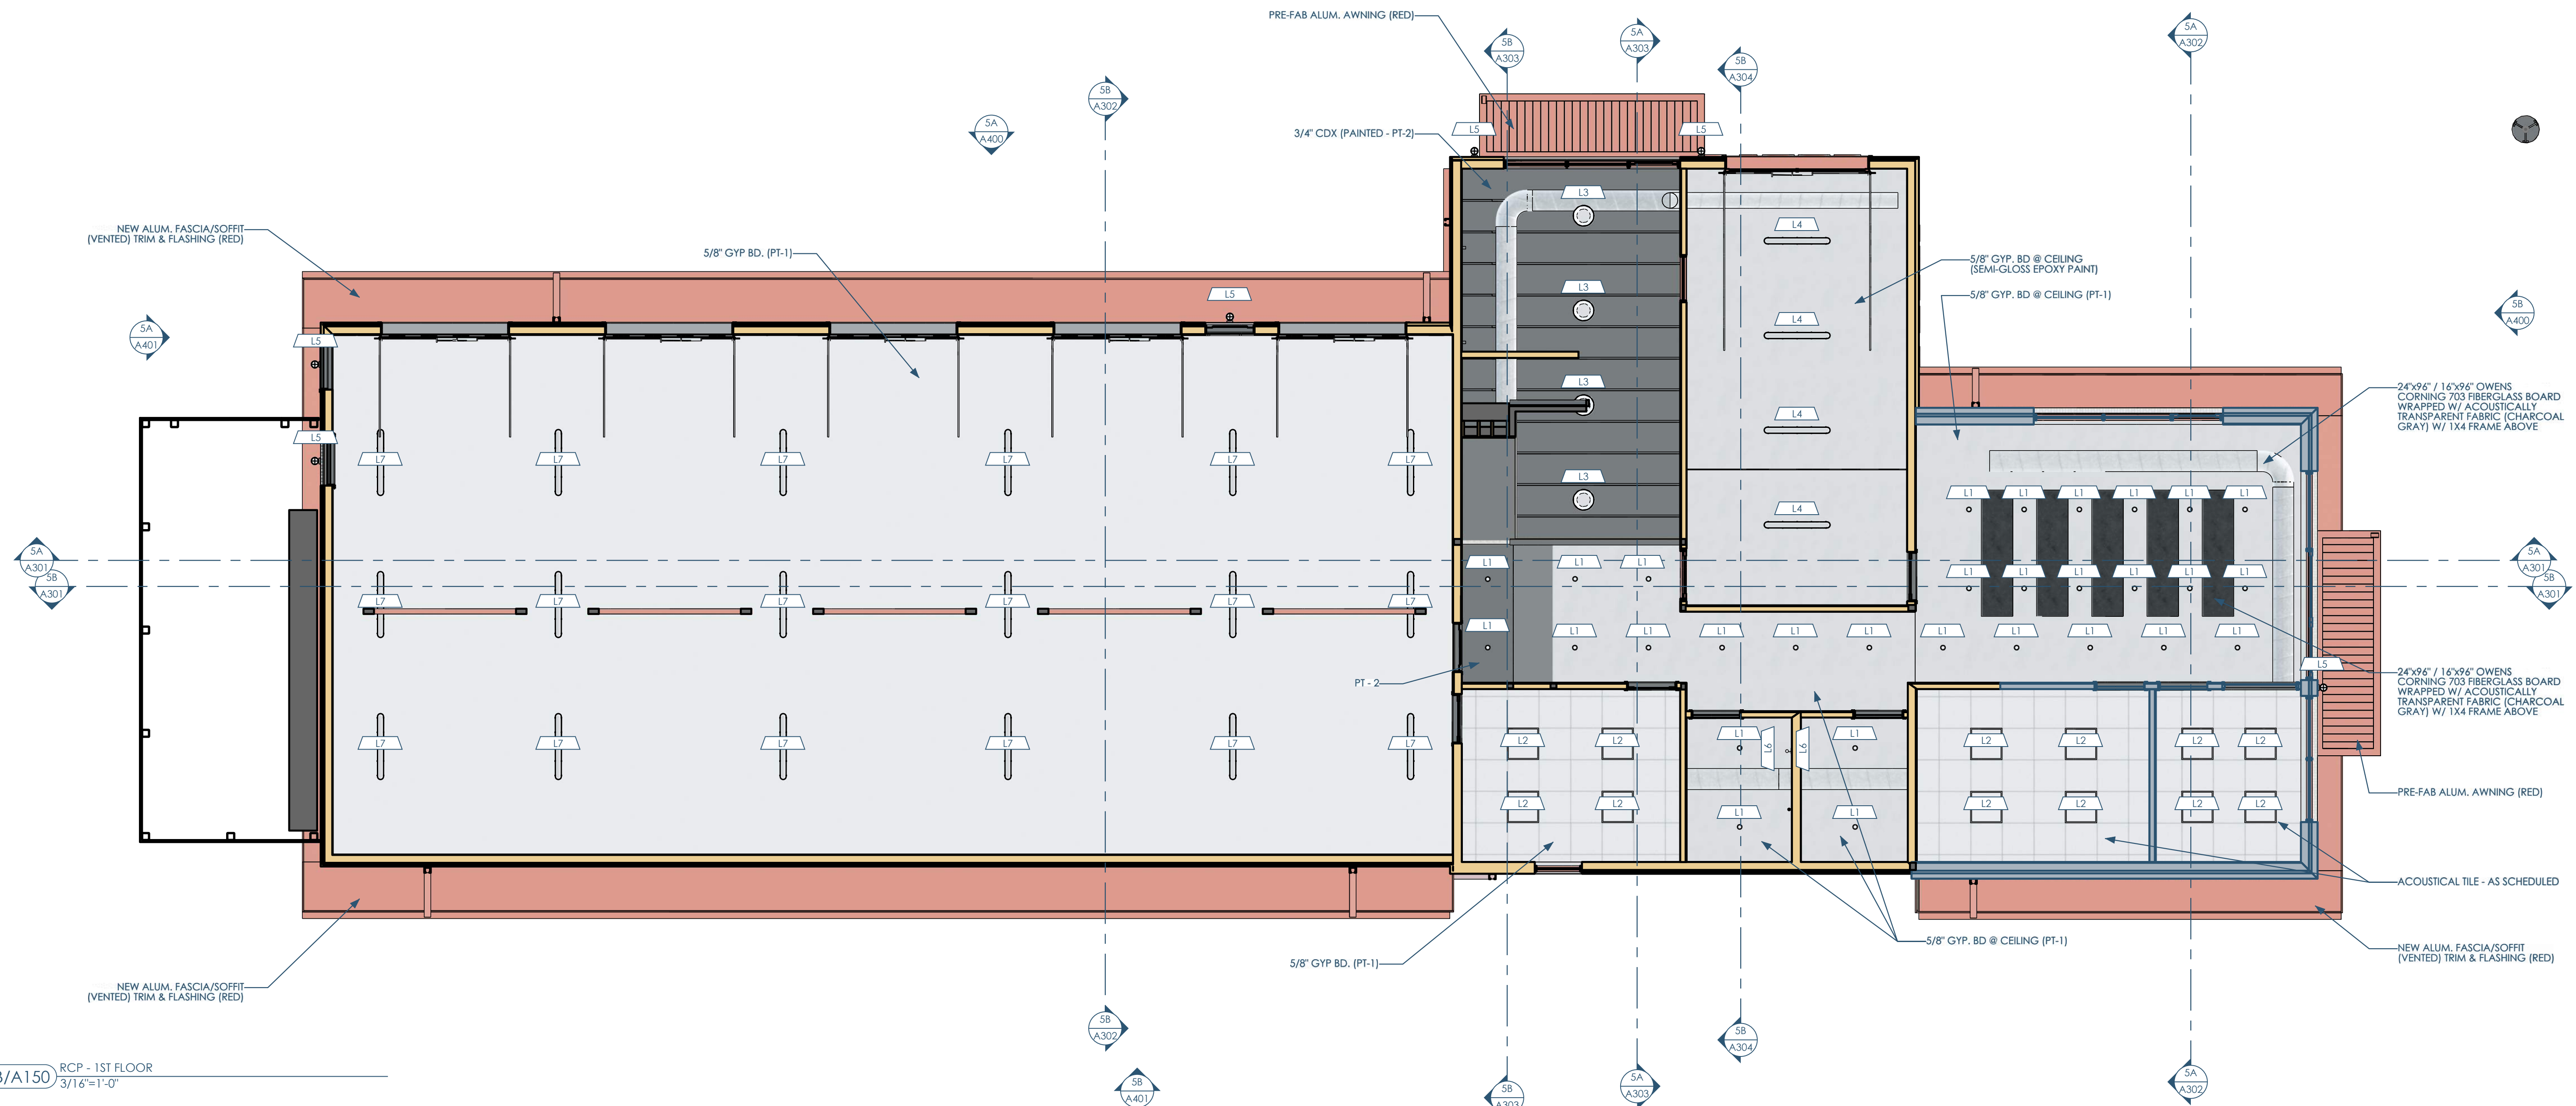

5B/A150 RCP - 1ST FLOOR
3/16"=1'-0"

MARK	TYPE	MANUFACTURER	MODEL	DESCRIPTION	TYPE COMMENTS	URL
L1	CAN LIGHT	LITHONIA	LDN4	MATTE BLACK TRIM	-	https://lithonia.com/59n59ry
L2	2X2 LED FLAT PANEL	LITHONIA	CPX 2X2 3200LM 80 CRI 30K SWL MINI0	-	-	https://lithonia.com/3yvwau65
L3	PENDANT	HYPERLITE	HERO SERIES W/ 60 REFLECTOR	BLACK BODY, CLEAR REFLECTOR	-	https://lithonia.com/2vwnu36j
L4	LINEAR LED	HYPERLITE	4FT VAPOR TIGHT LIGHT	-	-	https://lithonia.com/59fvcsa2
L5	WALL SCONCE	RAB	VBR100DGB	BLACK	-	https://lithonia.com/2694tmaj
L6	WALL SCONCE	STUFF BY ANDREW NEYER	PIPE LIGHT	BLACK	-	http://lithonia.com/3dauouse
L7	LINEAR LED	AGC LIGHTING	LHB16	-	-	https://lithonia.com/ymzutsv
L7a	24" DECORATIVE LINEAR LED	WESTGATE	SCE-SERIES	4FT (BLACK)	MOUNT TO B.O. TRUSS	https://lithonia.com/mprfxrs
L8	24" DECORATIVE LINEAR LED	WESTGATE	SCE-SERIES	4FT (BLACK)	VERTICAL WALL MOUNT	https://lithonia.com/mprfxrs
LIGHT POLE	LIGHT POLE	MATCH EXISTING	-	-	-	-


5A/A150 LIGHTING SCHEDULE

Owner: Cool Car Guys
1600 Center Ave
Janesville, WI 53546
608.531.1600

GC: Lake Country Construction Group
161 Horizon Dr
Verona, WI 53593
608.845.1398

Architect: Opening Design
17 S Fairchild | FL 7
Madison, WI 53703
ryan@openingdesign.com | 773.425.6456

This project, like most Opening Design's projects, is open source (Attribution-ShareAlike 4.0 International - CC BY-SA 4.0) - freely available to any party for future use - assuming the terms such as Attribution and ShareAlike are honored.

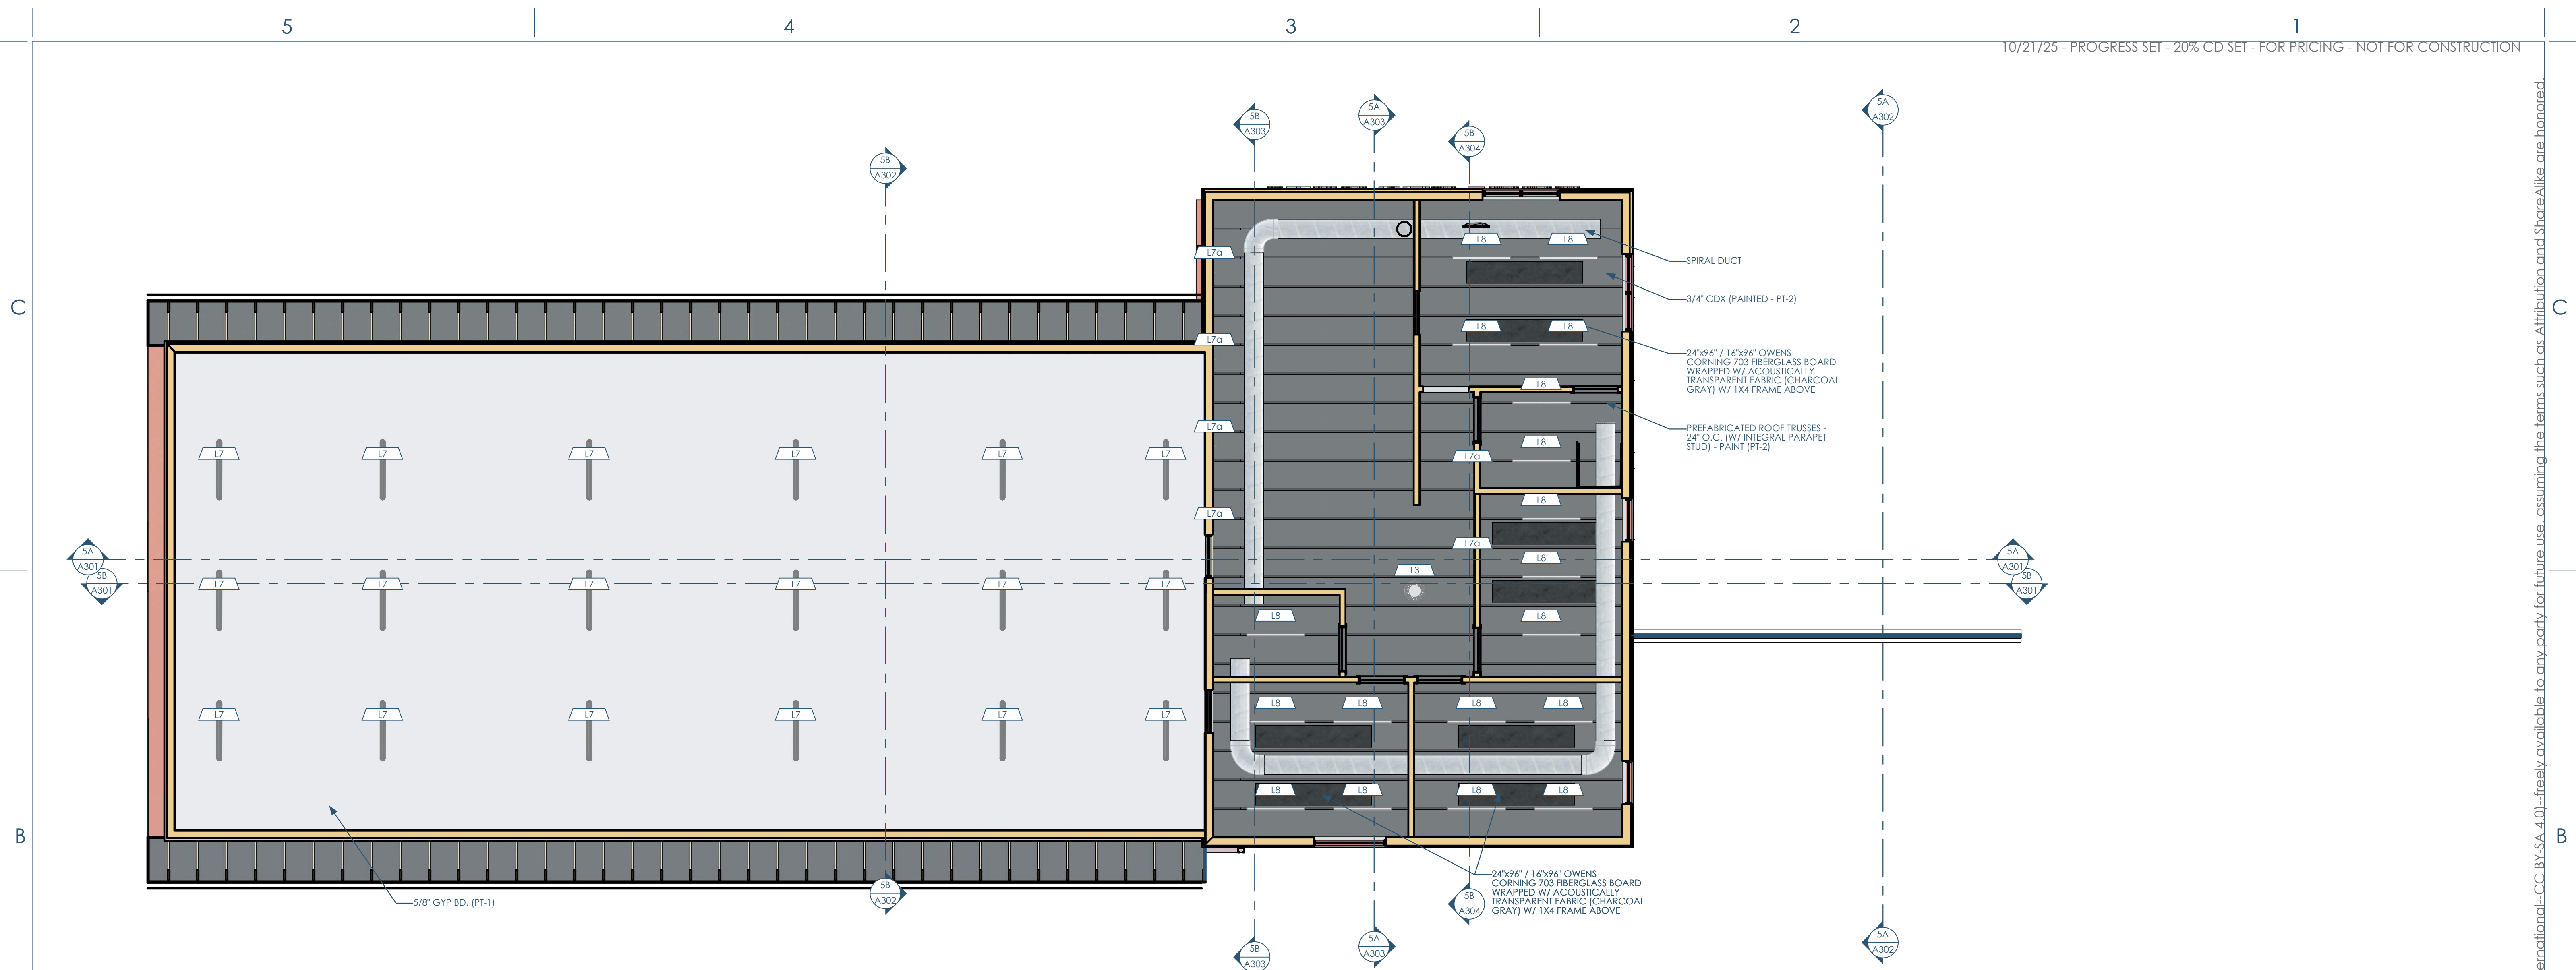

5B/A151 RCP - MEZZ. FLOOR
3/16"=1'-0"



Owner: Cool Car Guys
1600 Center Ave
Janesville, WI 53546
608.531.1600



GC: Lake Country Construction Group
161 Horizon Dr
Verona, WI 53593
608.845.1398




Architect: Opening Design
17 S Fairchild | FL 7
Madison, WI 53703
ryan@openingdesign.com | 773.425.6456


REFLECTED CEILING PLAN - MEZZ. FLOOR
COOL CAR GUYS
1600 CENTER AVE, JANESVILLE, WI 53546

A151

This project, like most Opening Design's projects, is open source. (Attribution-ShareAlike 4.0 International=CC BY-SA 4.0)=freely available to any party for future use...assuming the terms such as Attribution and ShareAlike are honored.

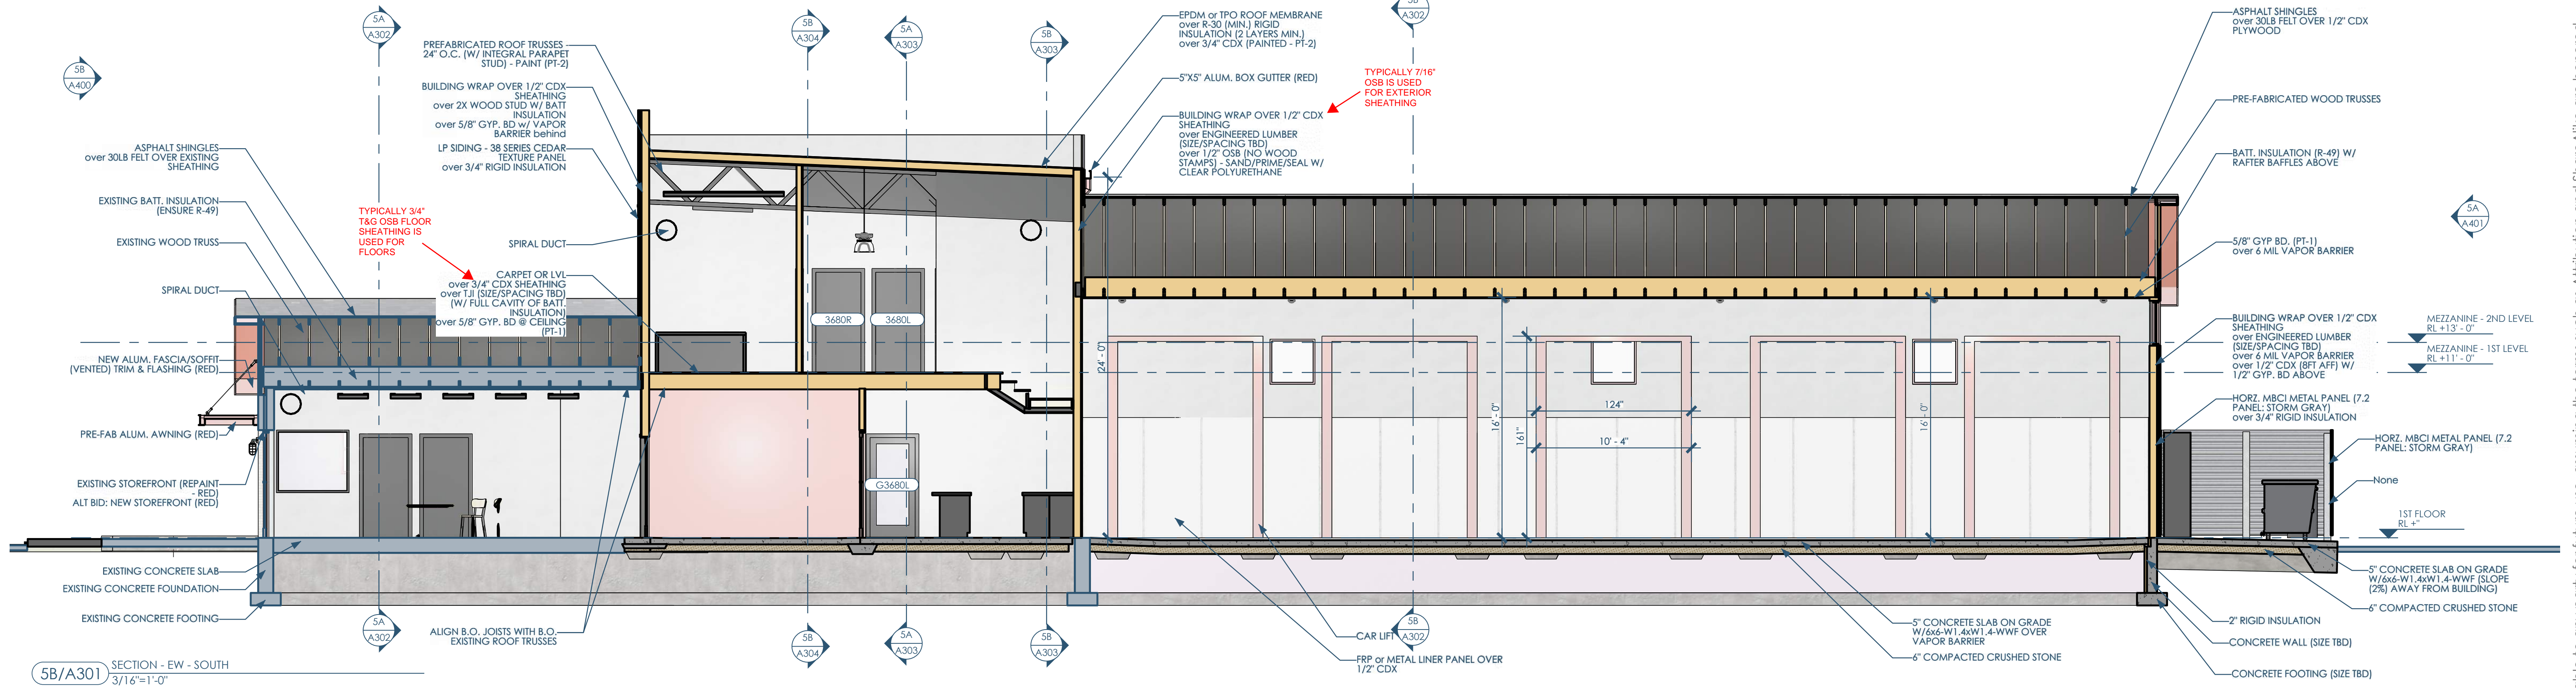


5B/A301 SECTION - EW - SOUTH
3/16"=1'-0"

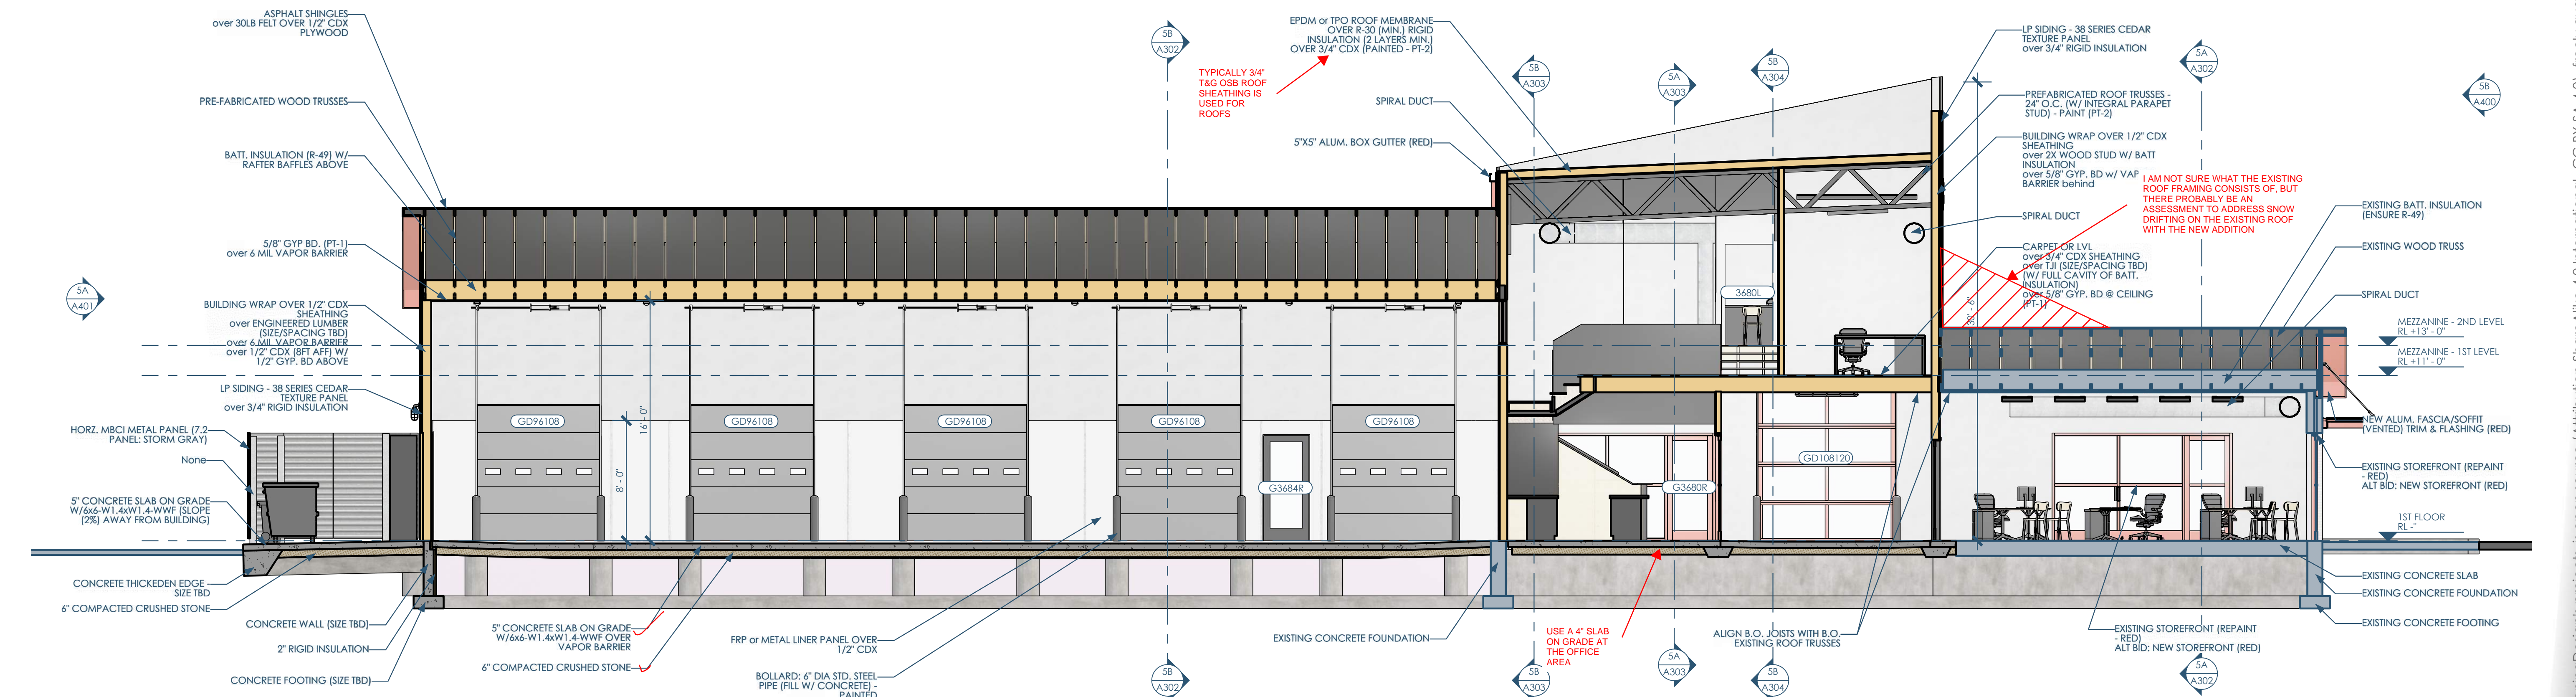

5A/A301 SECTION - EW - NORTH
3/16"=1'-0"


This project, like most Opening Design's projects, is open source (Attribution-ShareAlike 4.0 International - CC BY-SA 4.0) - freely available to any party for future use, assuming the terms such as Attribution and ShareAlike are honored.

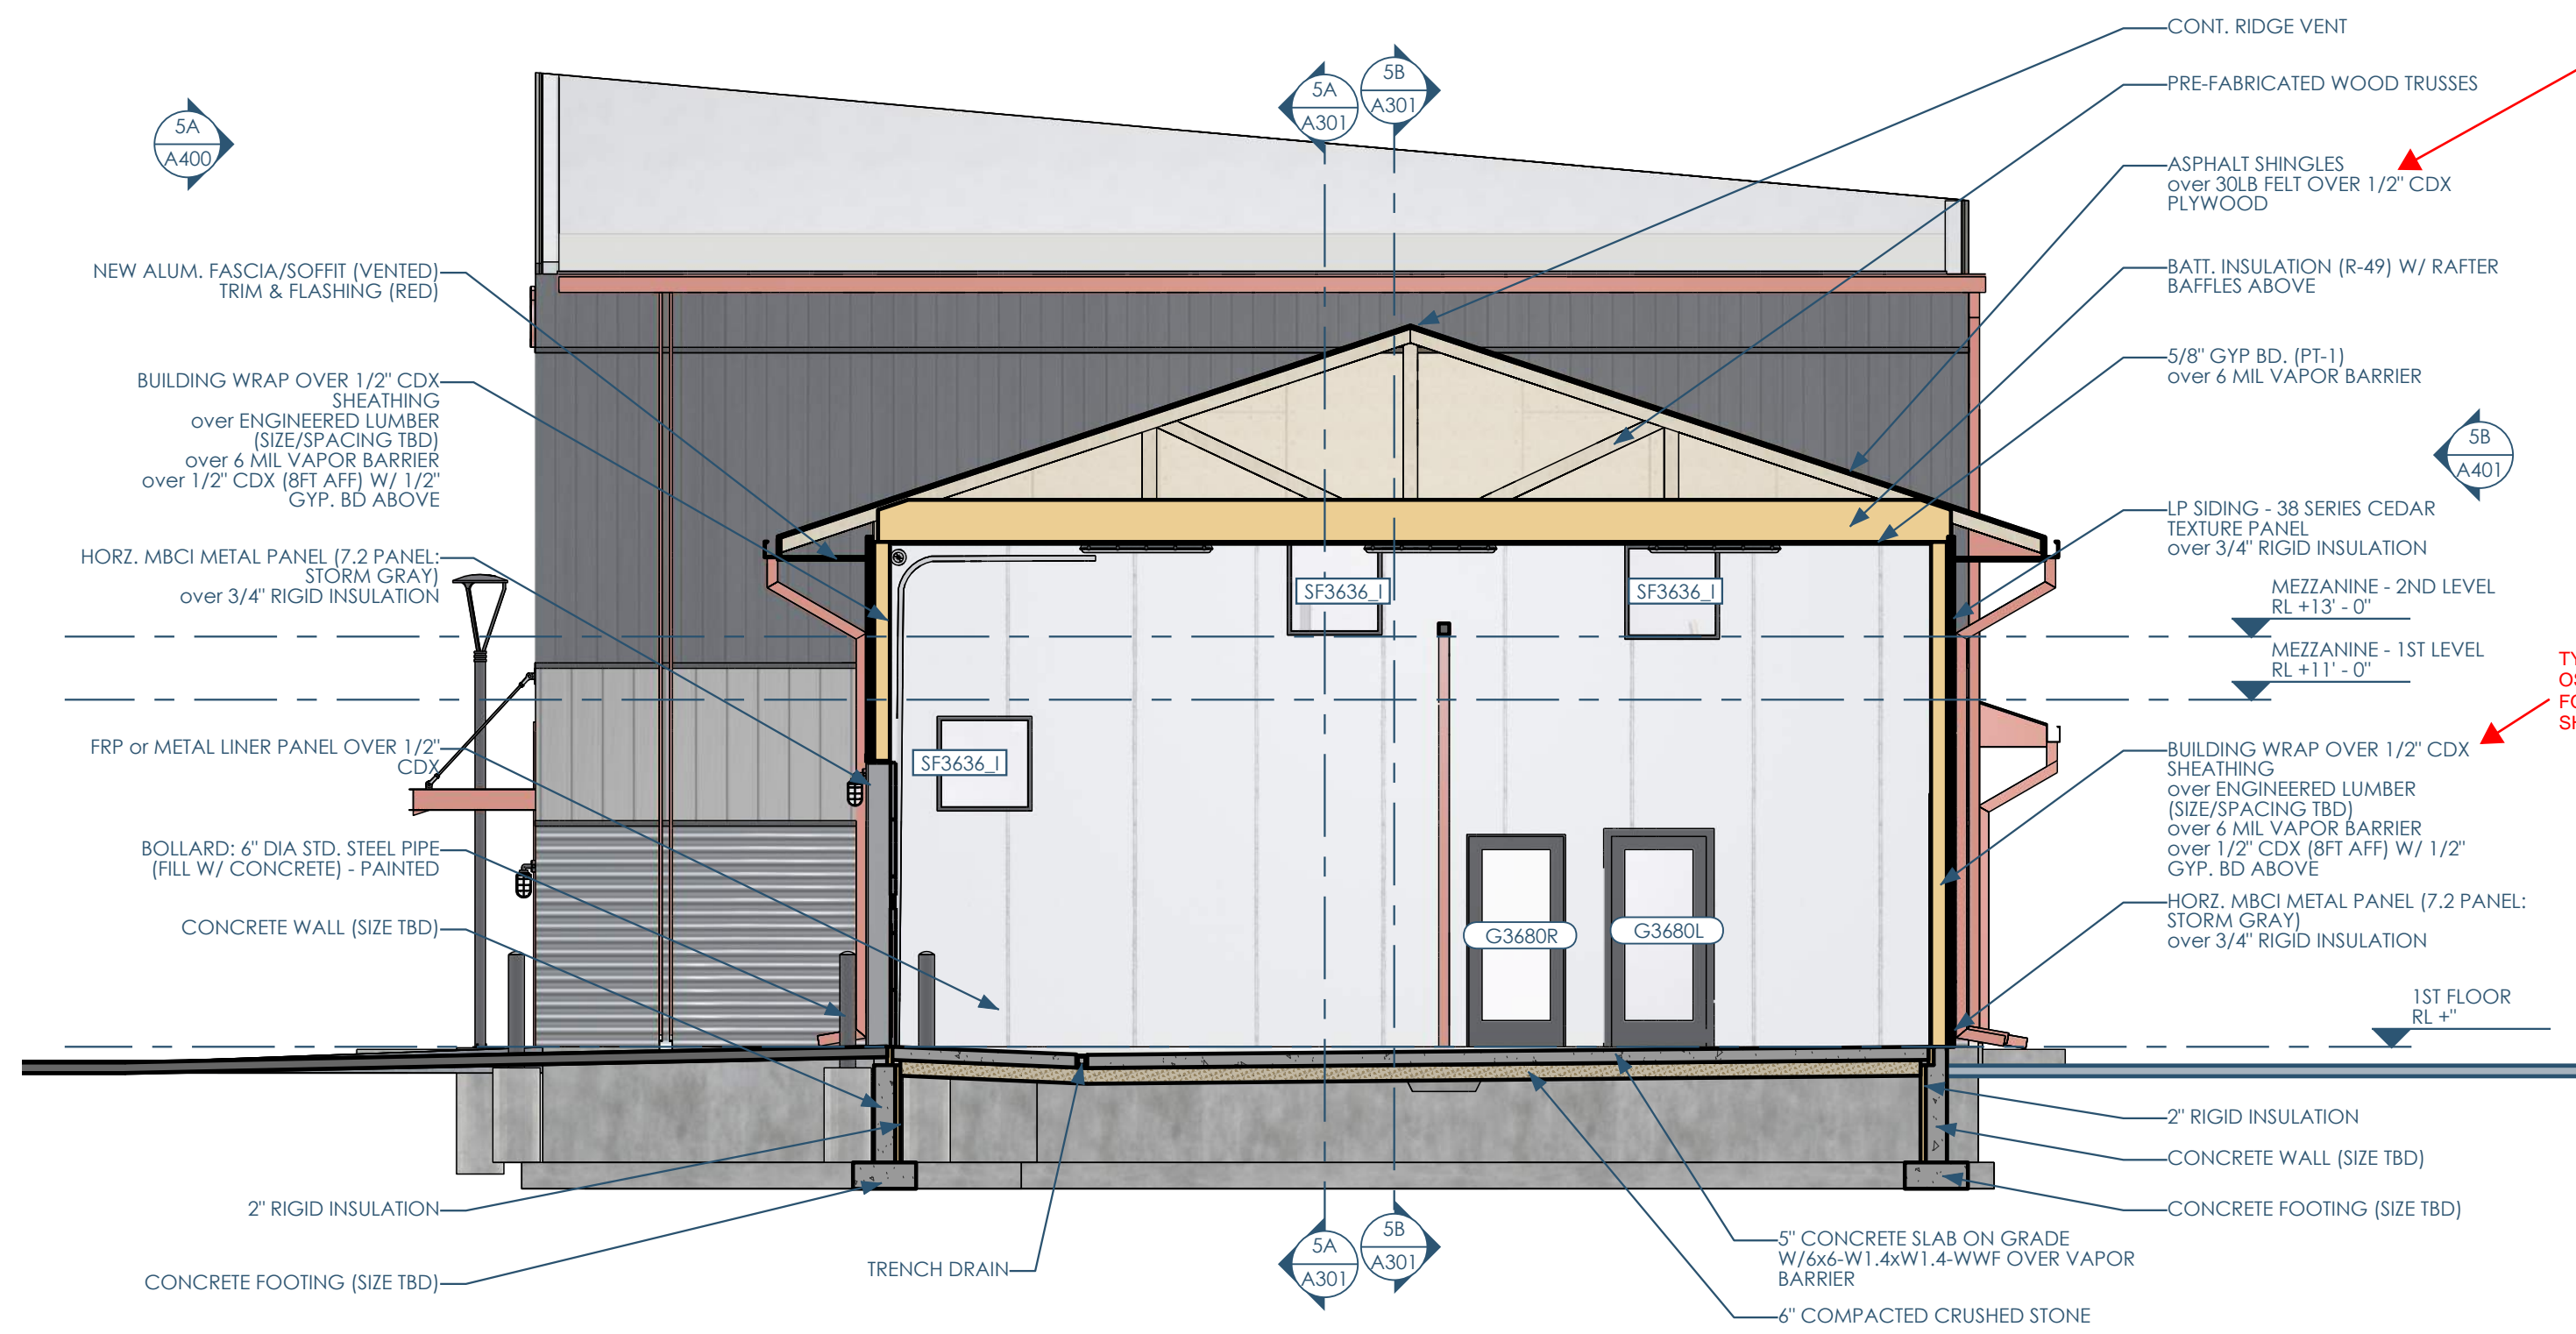

I WOULD RECOMMEND A MINIMUM OF 5/8\"/>

TYPICALLY 7/16\"/>

5B/A302 SECTION - NS - EAST - AT SERVICE BAY
3/16"=1'-0"

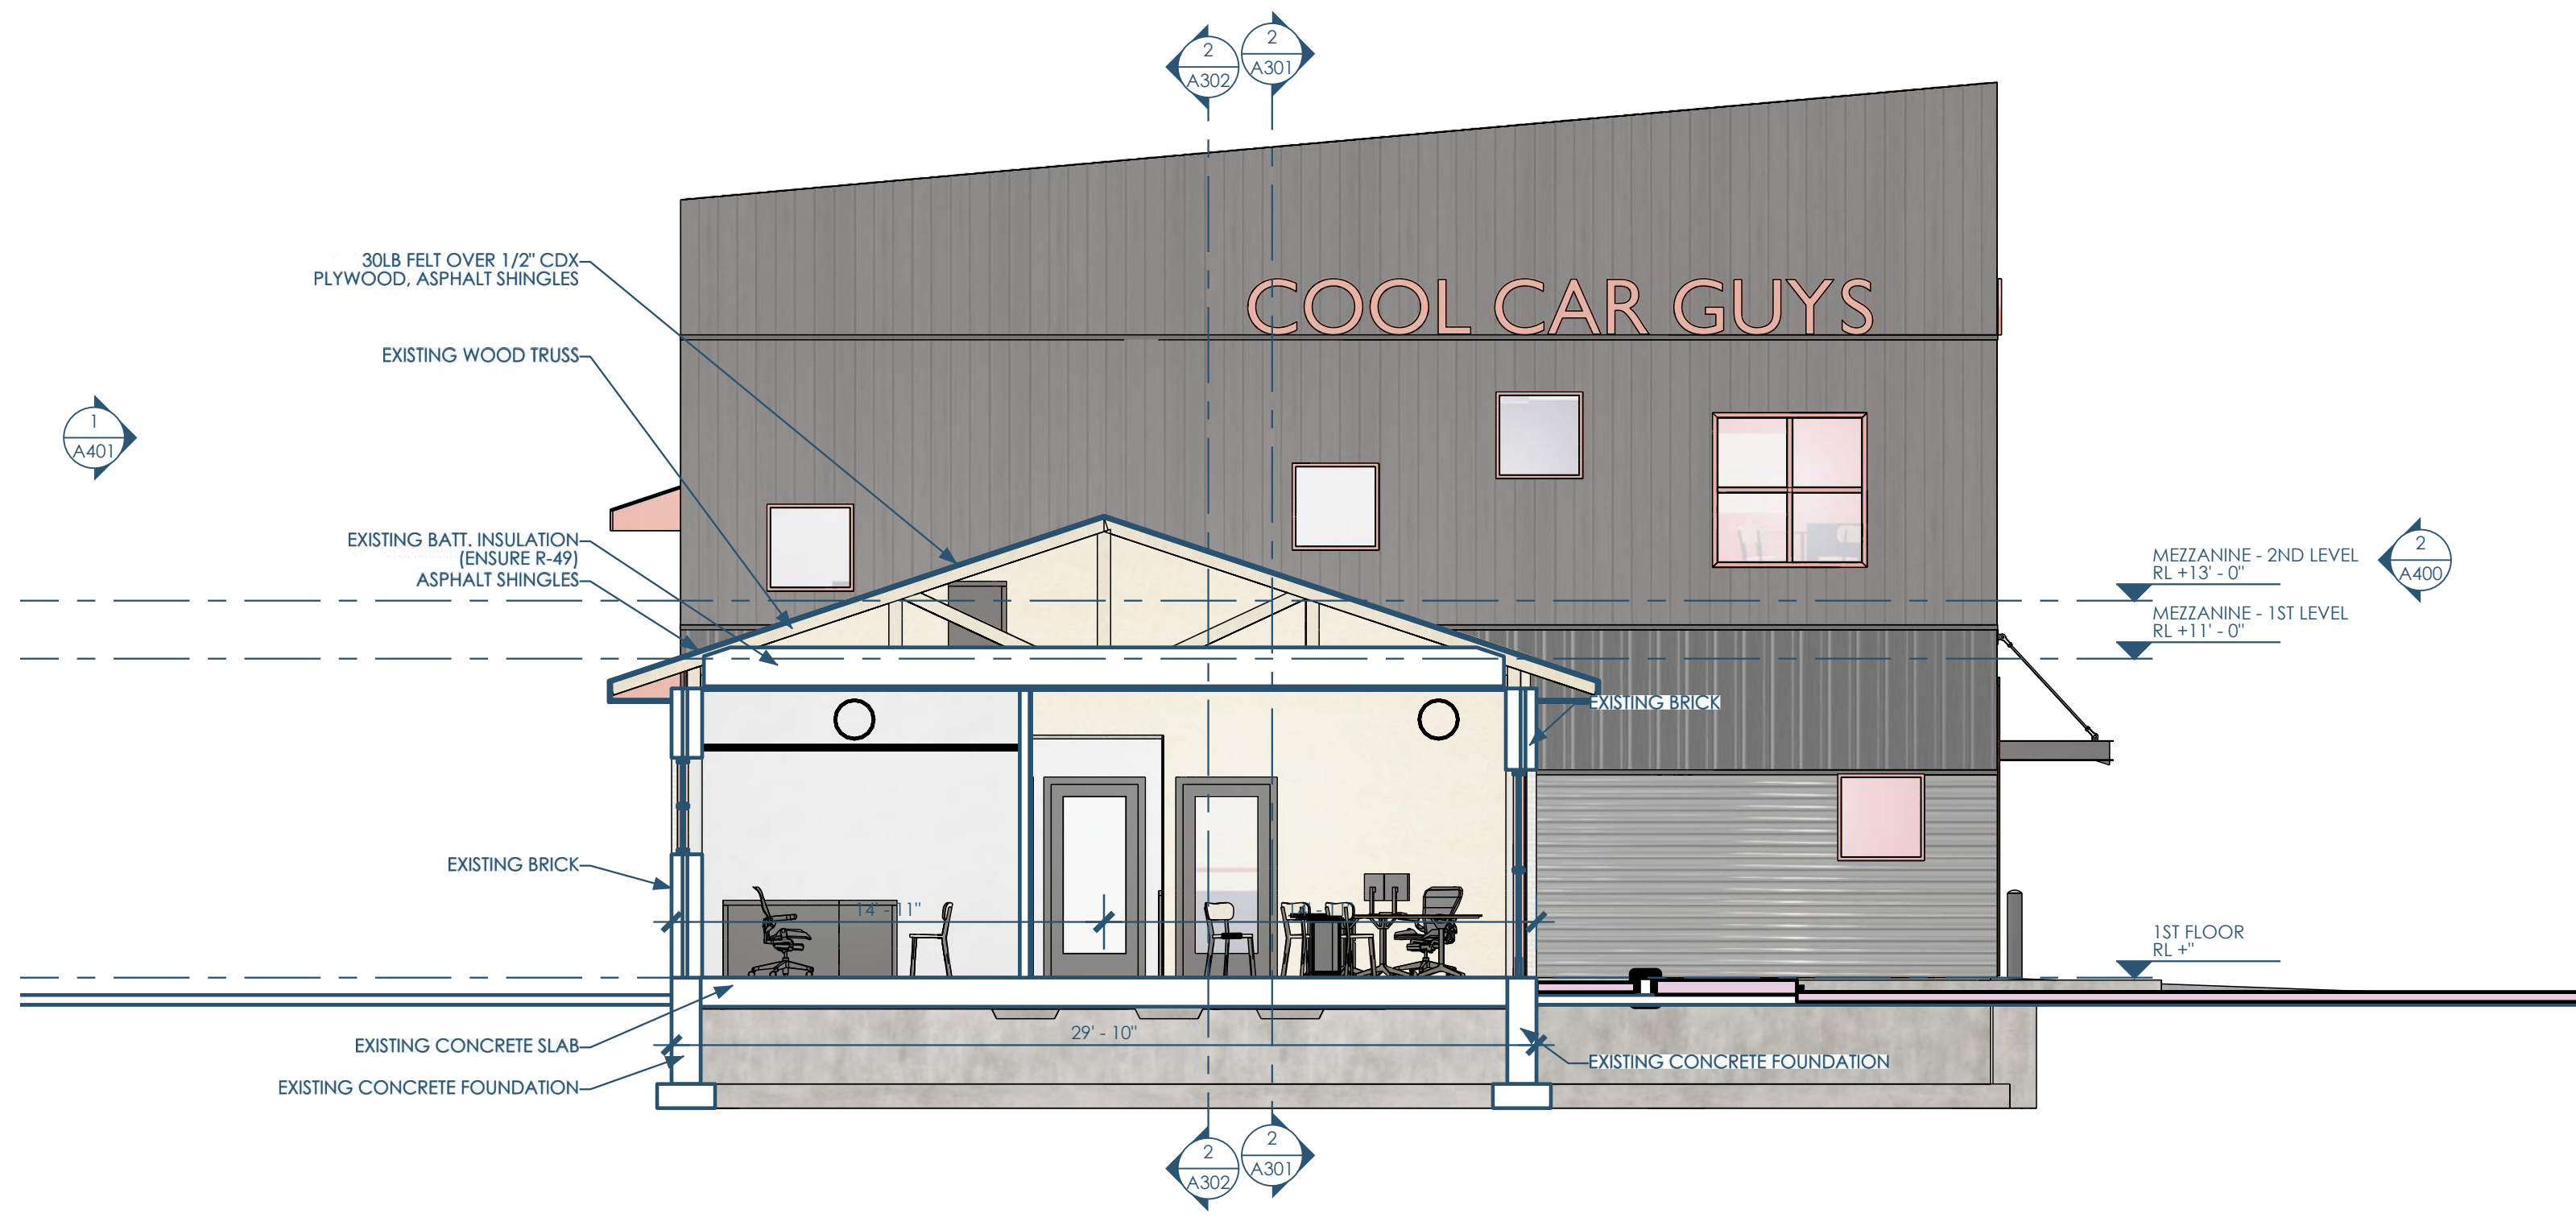

5A/A302 SECTION - NS - WEST - AT EX. LOBBY
3/16"=1'-0"



Owner: Cool Car Guys
1600 Center Ave
Janesville, WI 53546
608.531.1600


GC: Lake Country Construction Group
161 Horizon Dr
Verona, WI 53593
608.845.1398

Architect: Opening Design
17 S Fairchild | FL 7
Madison, WI 53703
ryan@openingdesign.com | 773.425.6456


SECTIONS
COOL CAR GUYS
1600 CENTER AVE, JANESVILLE, WI 53546

A302

This project, like most Opening Design's projects, is open source (Attribution-ShareAlike 4.0 International=CC BY-SA 4.0) - freely available to any party for future use, assuming the terms such as Attribution and ShareAlike are honored.

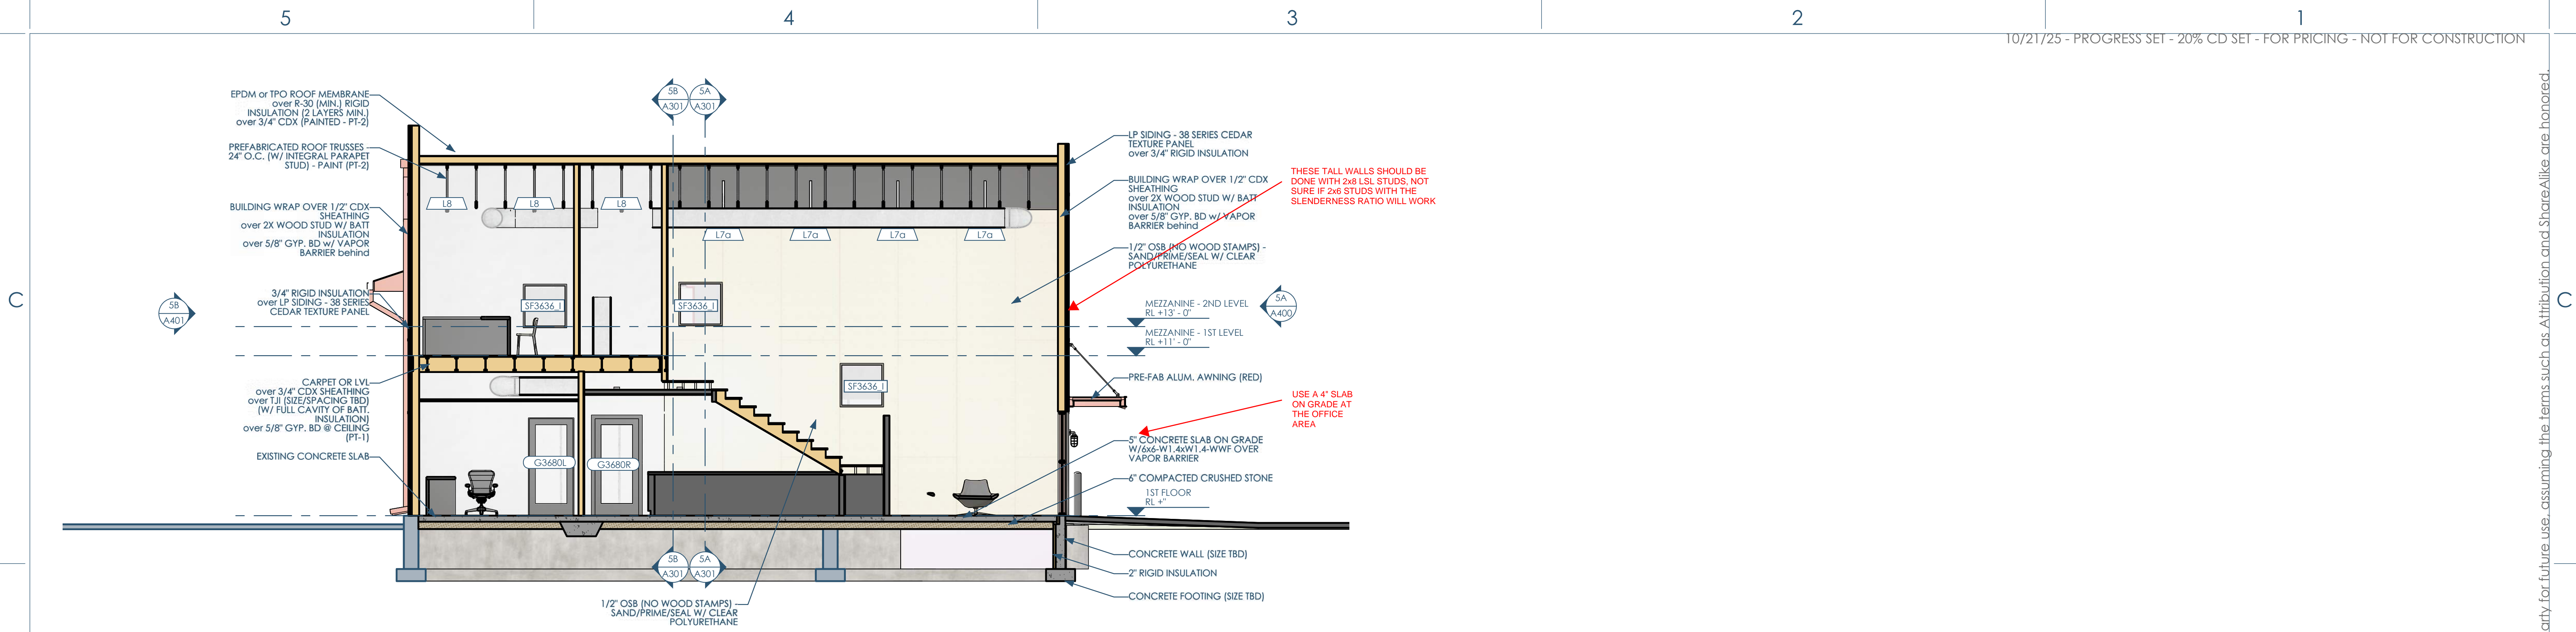

5B/A303 SECTION - NS - WEST - AT LOBBY AND STAIRS
3/16"=1'-0"

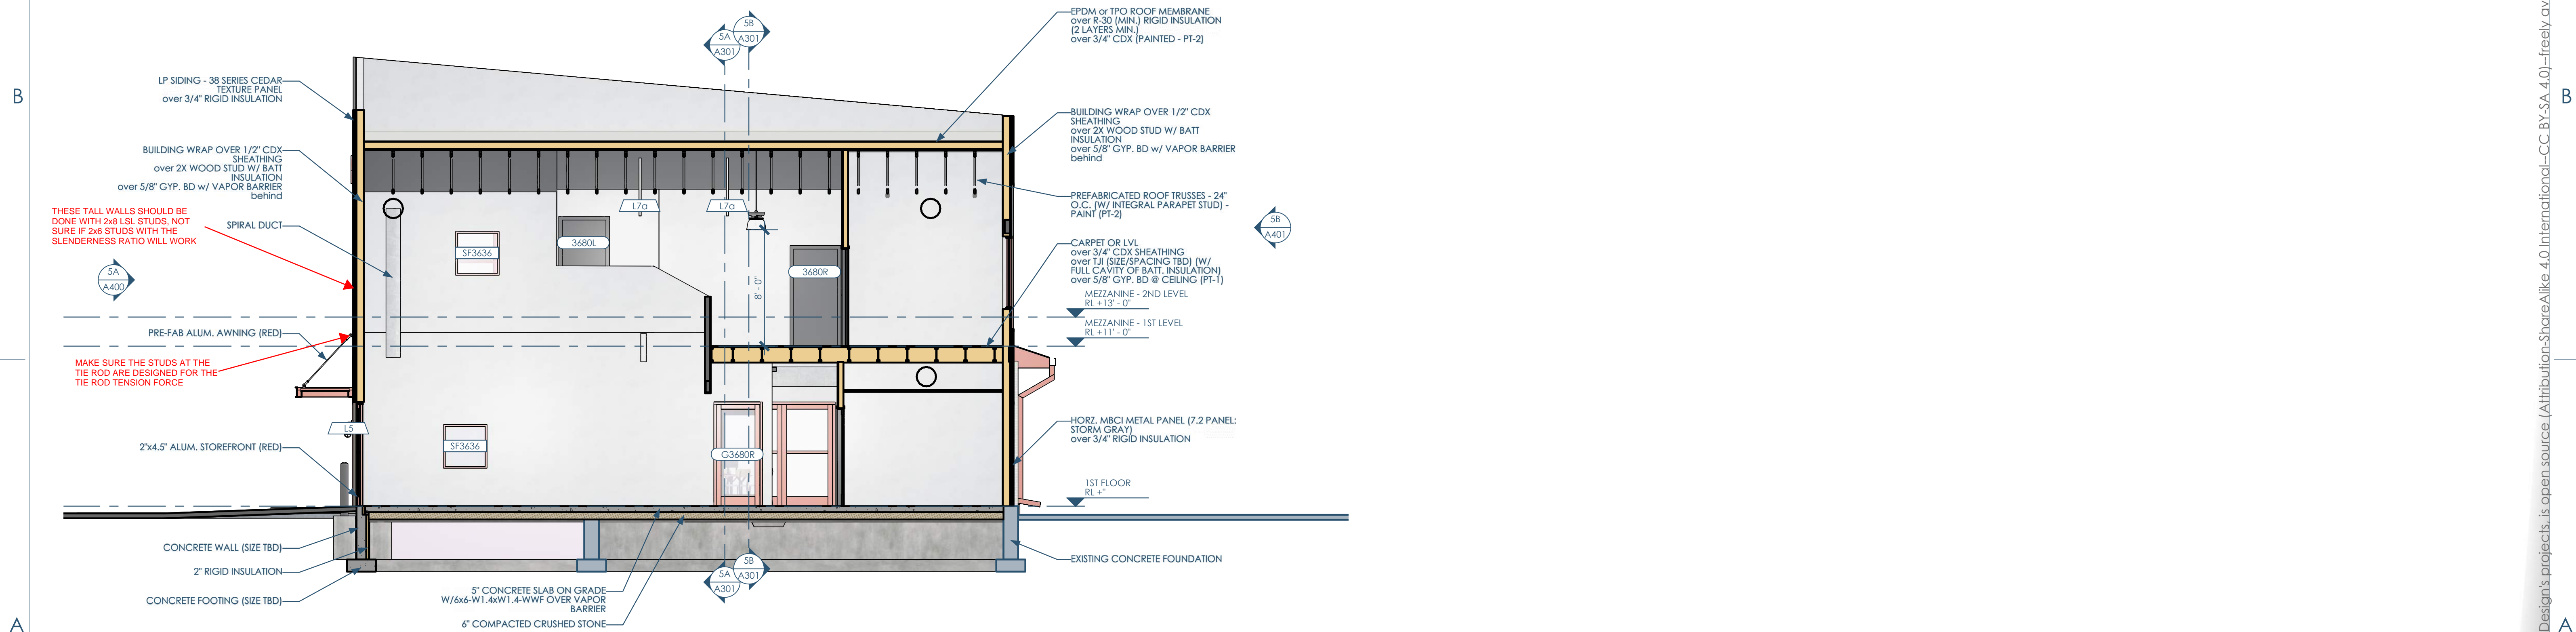

5A/A303 SECTION - NS - EAST - AT LOBBY
3/16"=1'-0"



Owner: Cool Car Guys
1600 Center Ave
Janesville, WI 53546
608.531.1600


GC: Lake Country Construction Group
161 Horizon Dr
Verona, WI 53593
608.845.1398

Architect: Opening Design
17 S Fairchild | FL 7
Madison, WI 53703
ryan@openingdesign.com | 773.425.6456

SECTIONS
COOL CAR GUYS
1600 CENTER AVE, JANESVILLE, WI 53546

A303

This project, like most Opening Design's projects, is open source (Attribution-ShareAlike 4.0 International) - freely available to any party for future use, assuming the terms such as Attribution and ShareAlike are honored.

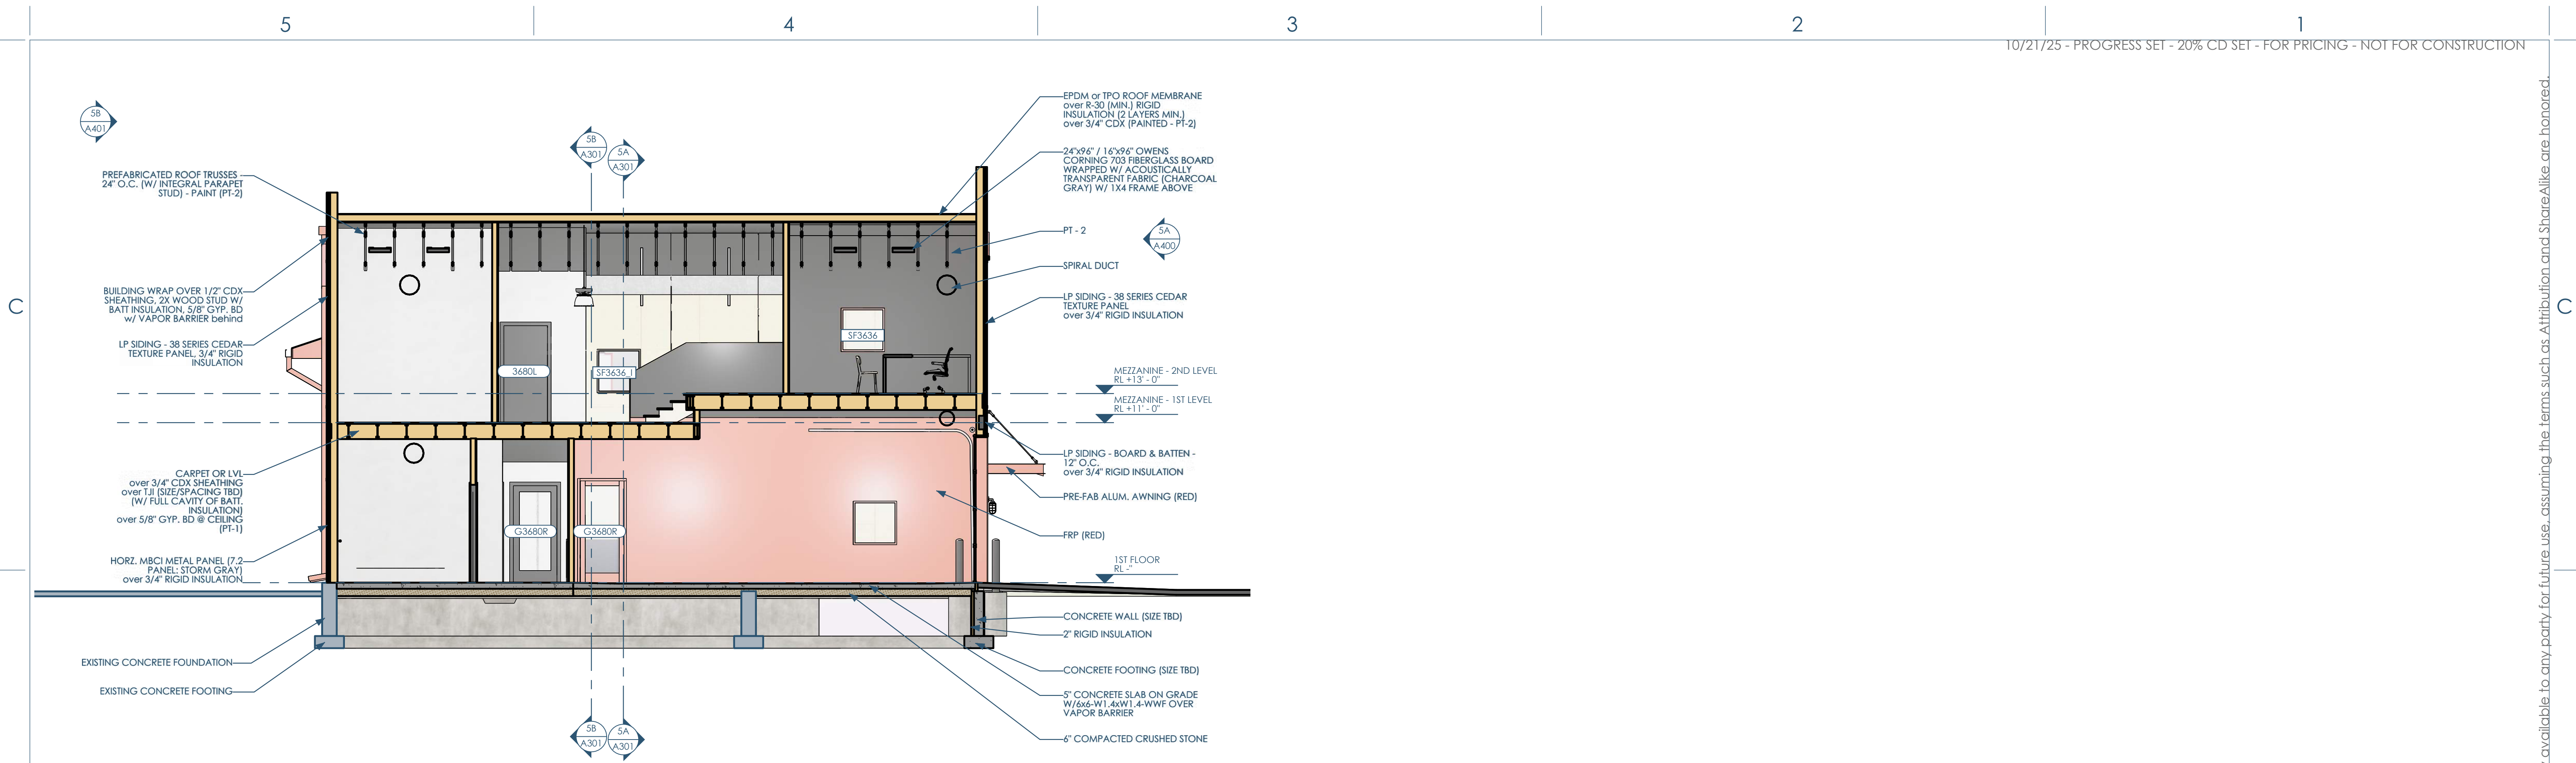

5B/A304 SECTION - NS - WEST - AT DROPOFF BAY
3/16"=1'-0"

A
B
C



Owner: Cool Car Guys
1600 Center Ave
Janeshville, WI 53546
608.531.1600



GC: Lake Country Construction Group
161 Horizon Dr
Verona, WI 53593
608.845.1398




Architect: Opening Design
17 S Fairchild | FL 7
Madison, WI 53703
ryan@openingdesign.com | 773.425.6456

SECTIONS
COOL CAR GUYS


1600 CENTER AVE, JANESVILLE, WI 53546

A304


This project, like most Opening Design's projects, is open source (Attribution-ShareAlike 4.0 International=CC BY-SA 4.0) - freely available to any party for future use... assuming the terms such as Attribution and ShareAlike are honored.

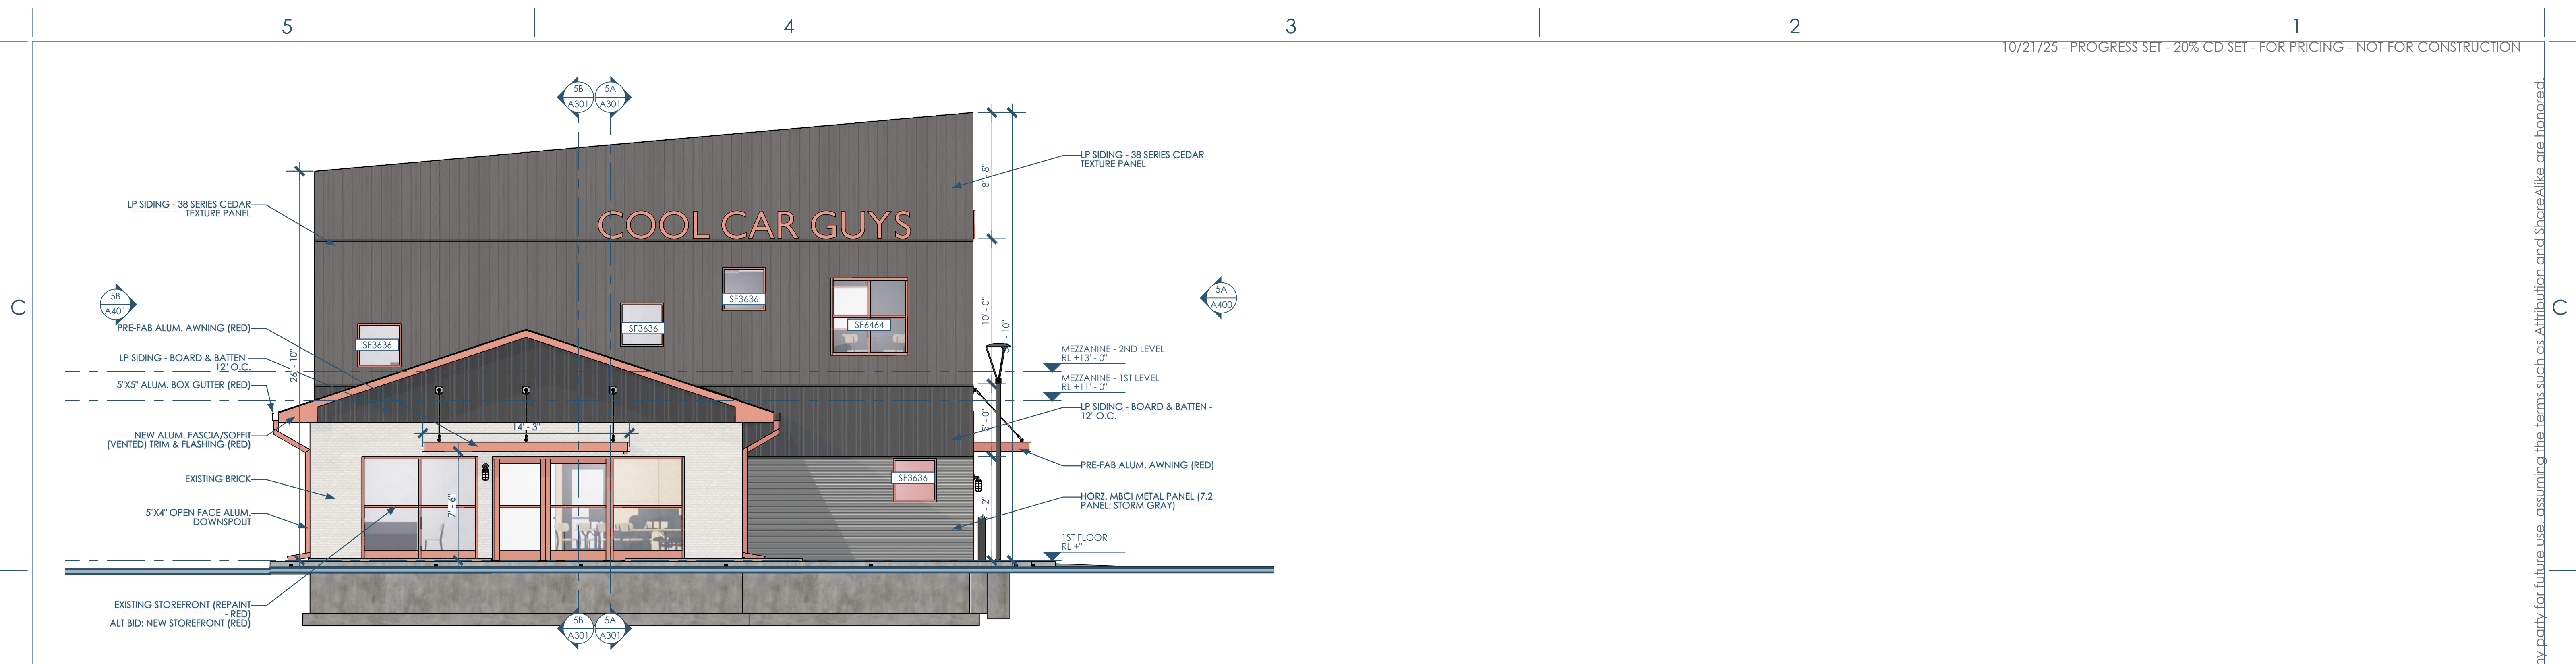

5B/A400 ELEVATION - EAST - AT CENTER AVE
3/16"=1'-0"

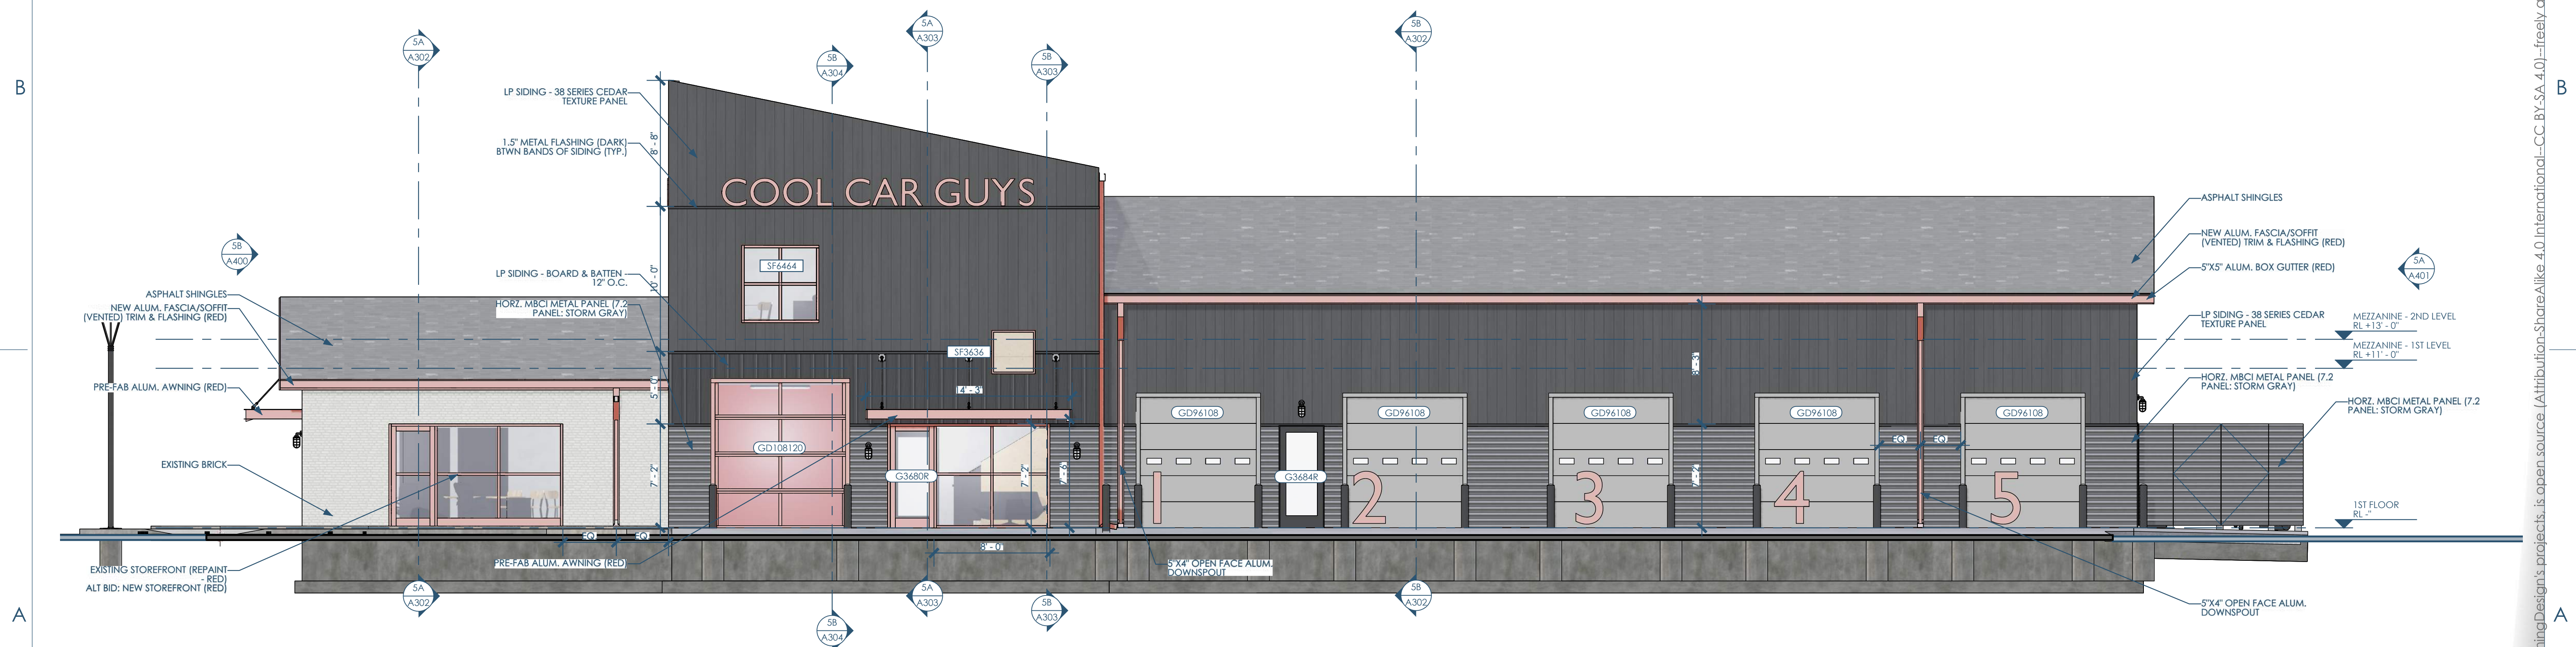


5A/A400 ELEVATION - NORTH - AT JOLIET ST
3/16"=1'-0"



LAKE COUNTRY
 CONSTRUCTION GROUP
 Owner: Cool Car Guys
 1600 Center Ave
 Janesville, WI 53546
 608.531.1600


openingdesign
 Architect: Opening Design
 17 S Fairchild | FL 7
 Madison, WI 53703
 ryan@openingdesign.com | 773.425.6456

This project, like most OpeningDesign's projects, is open source (Attribution-ShareAlike 4.0 International=CC BY-SA 4.0) - freely available to any party for future use - assuming the terms such as Attribution and ShareAlike are honored.

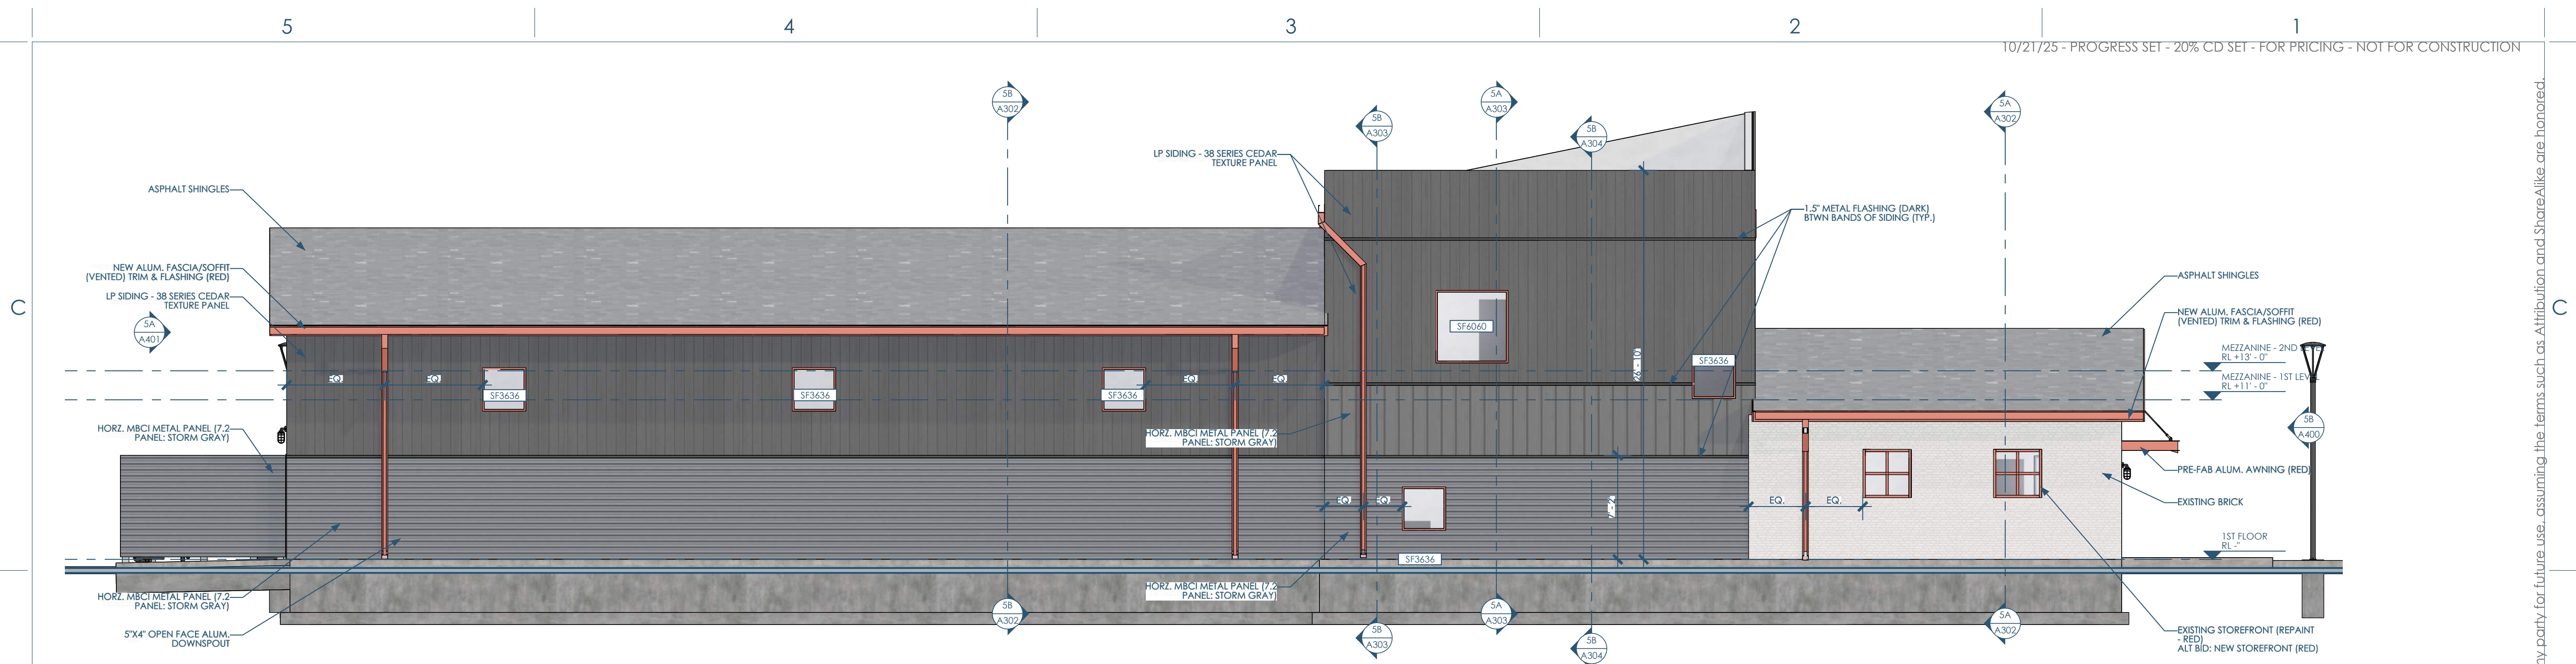

5B/A401 ELEVATION - SOUTH
3/16"=1'-0"

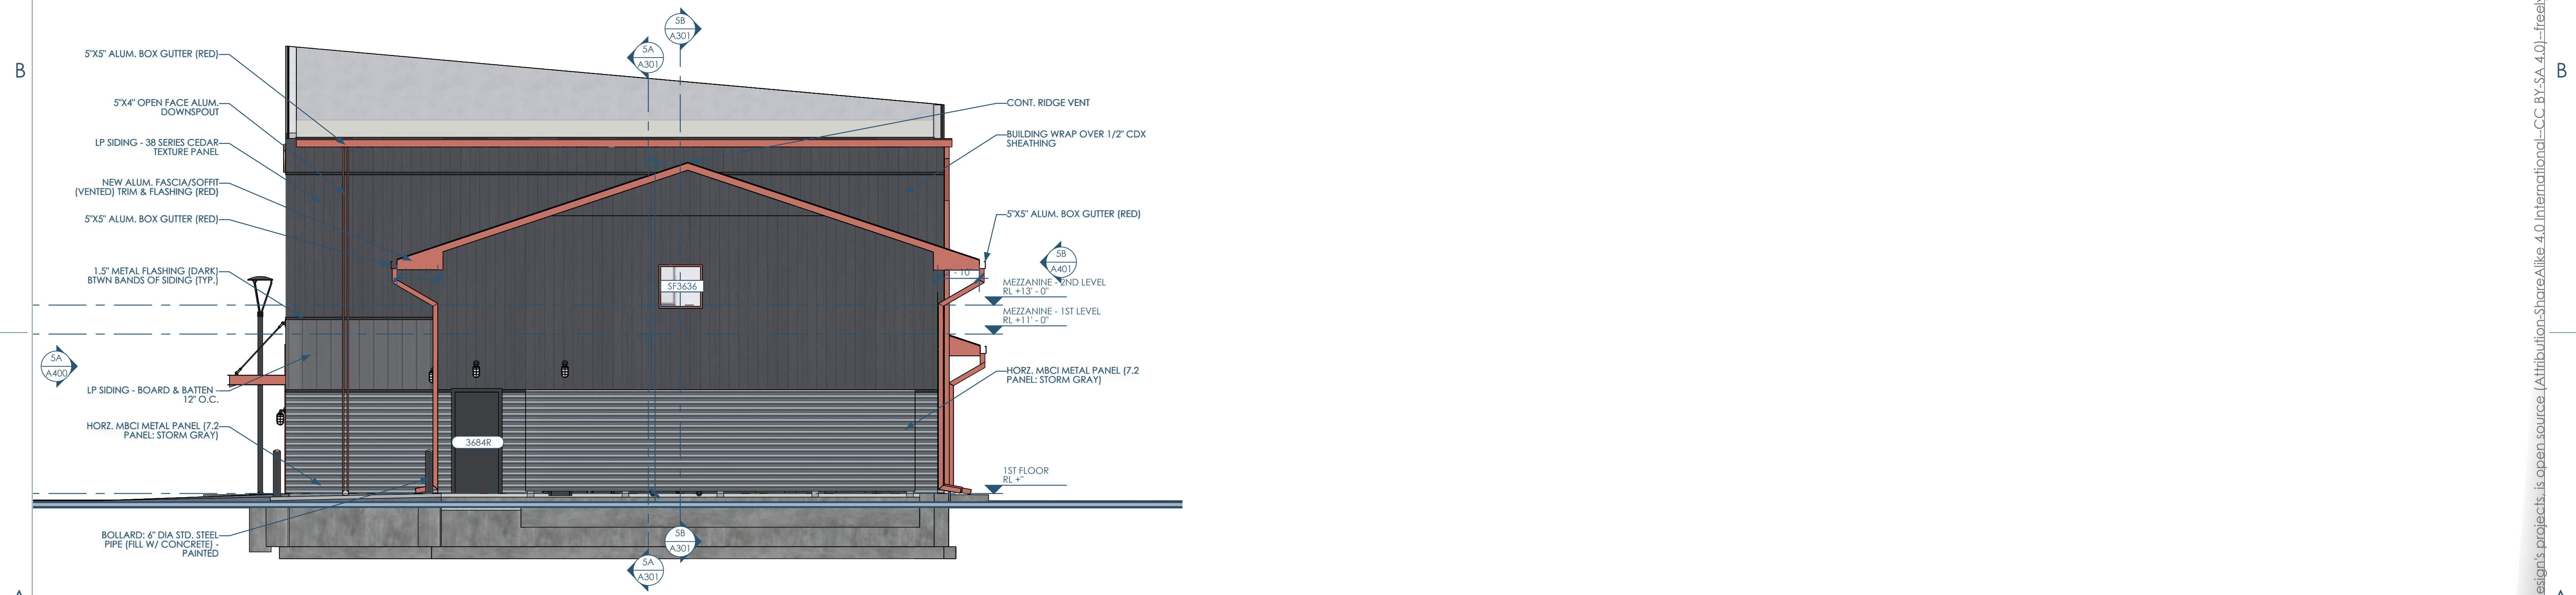

5A/A401 ELEVATION - WEST
3/16"=1'-0"



LAKE COUNTRY
CONSTRUCTION GROUP



Owner: Cool Car Guys
1600 Center Ave
Janesville, WI 53546
608.531.1600

GC: Lake Country Construction Group
161 Horizon Dr
Verona, WI 53593
608.845.1398

Architect: Opening Design
17 S Fairchild | FL 7
Madison, WI 53703
ryan@openingdesign.com | 773.425.6456

ELEVATIONS
COOL CAR GUYS
1600 CENTER AVE, JANESVILLE, WI 53546

A401

This project, like most Opening Design's projects, is open source (Attribution-ShareAlike 4.0 International=CC BY-SA 4.0) - freely available to any party for future use - assuming the terms such as Attribution and ShareAlike are honored.



5C/A900 PERSPECTIVE - CENTER AVE. - NORTH



4C/A900 PERSPECTIVE - CENTER AVE. - SOUTH




2C/A900 PERSPECTIVE - JOLIET ST.



5A/A900 PERSPECTIVE - LOBBY - LOOKING NORTH FROM MEZZ. STAIR



4A/A900 PERSPECTIVE - LOBBY - LOOKING NORTH

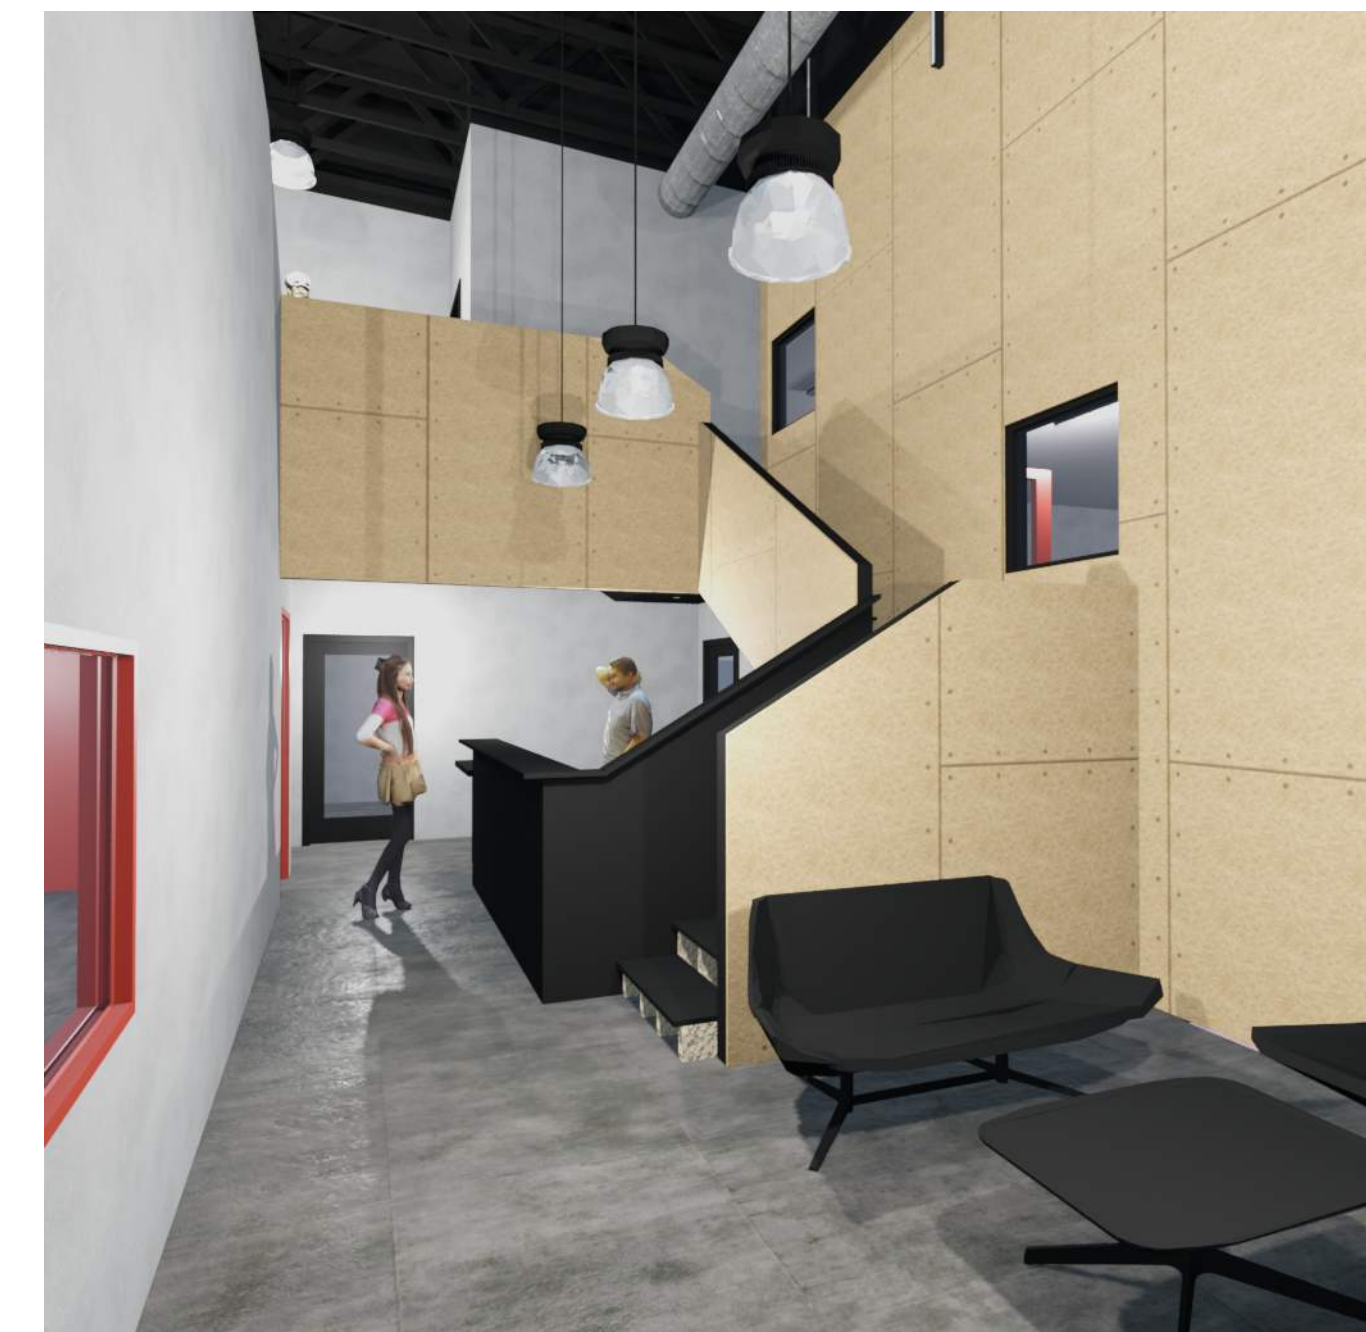

2A/A900 PERSPECTIVE - LOBBY - LOOKING SOUTH



Owner: Cool Car Guys
 1600 Center Ave
 Janesville, WI 53546
 608.531.1600



GC: Lake Country Construction Group
 161 Horizon Dr
 Verona, WI 53593
 608.845.1398




Architect: Opening Design
 17 S Fairchild | FL 7
 Madison, WI 53703
 ryan@openingdesign.com | 773.425.6456


RENDERINGS
 COOL CAR GUYS
 1600 CENTER AVE, JANESVILLE, WI 53546

A900


This project, like most Opening Design's projects, is open source (Attribution-ShareAlike 4.0 International=CC BY-SA 4.0) - freely available to any party for future use, assuming the terms such as Attribution and ShareAlike are honored.

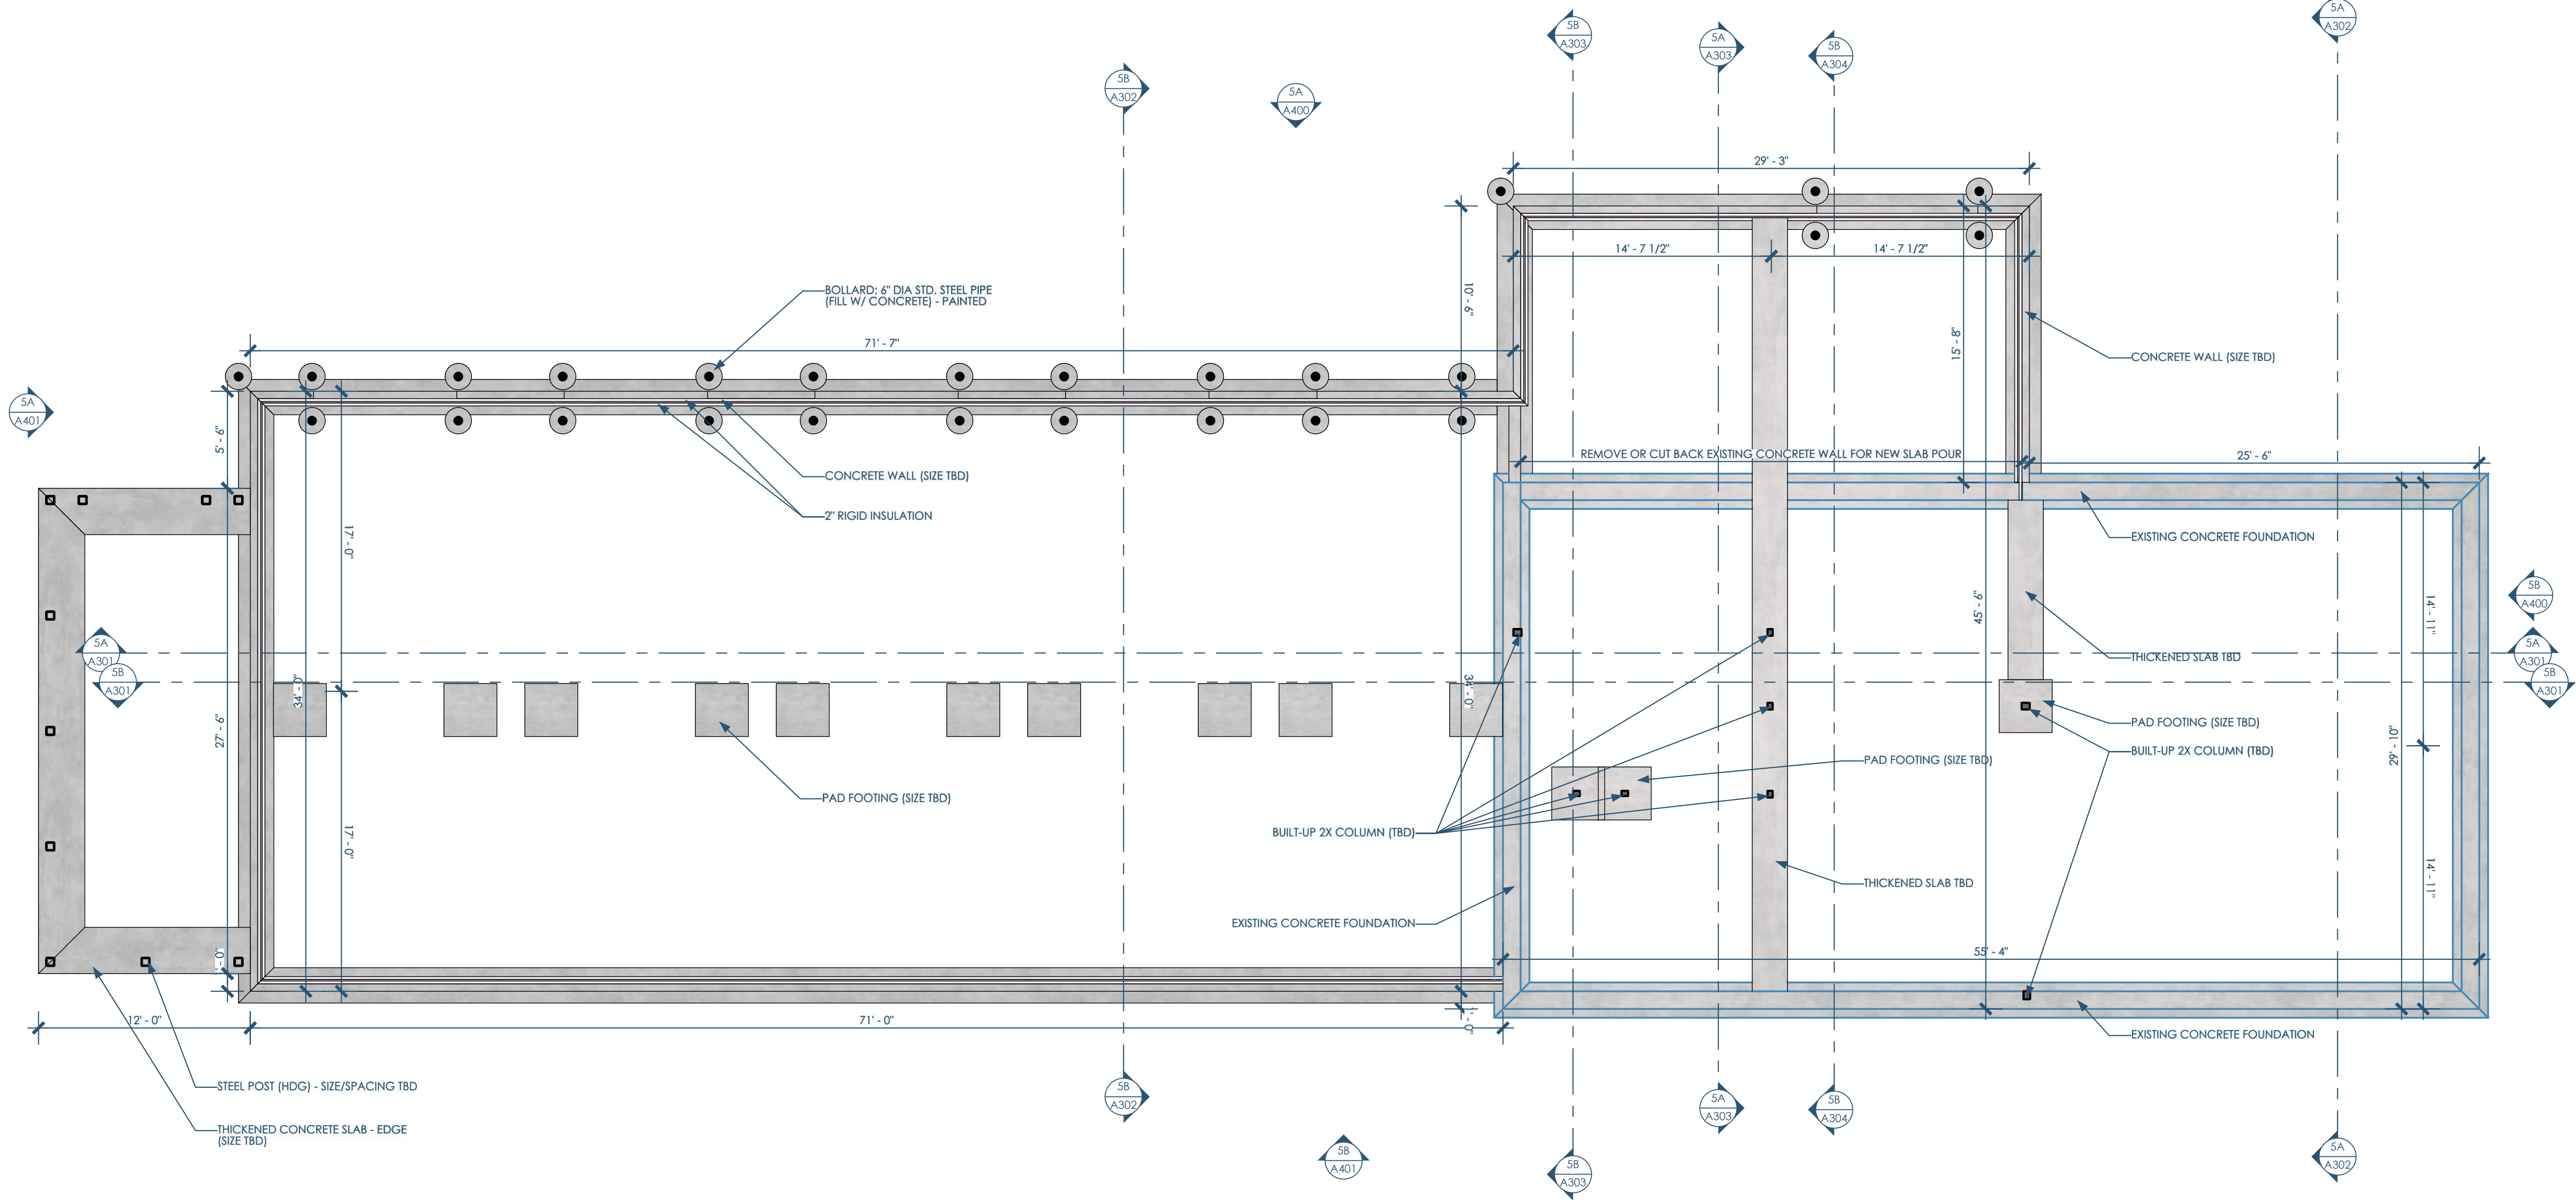

5B/S101 FOUNDATION PLAN
3/16"=1'-0"

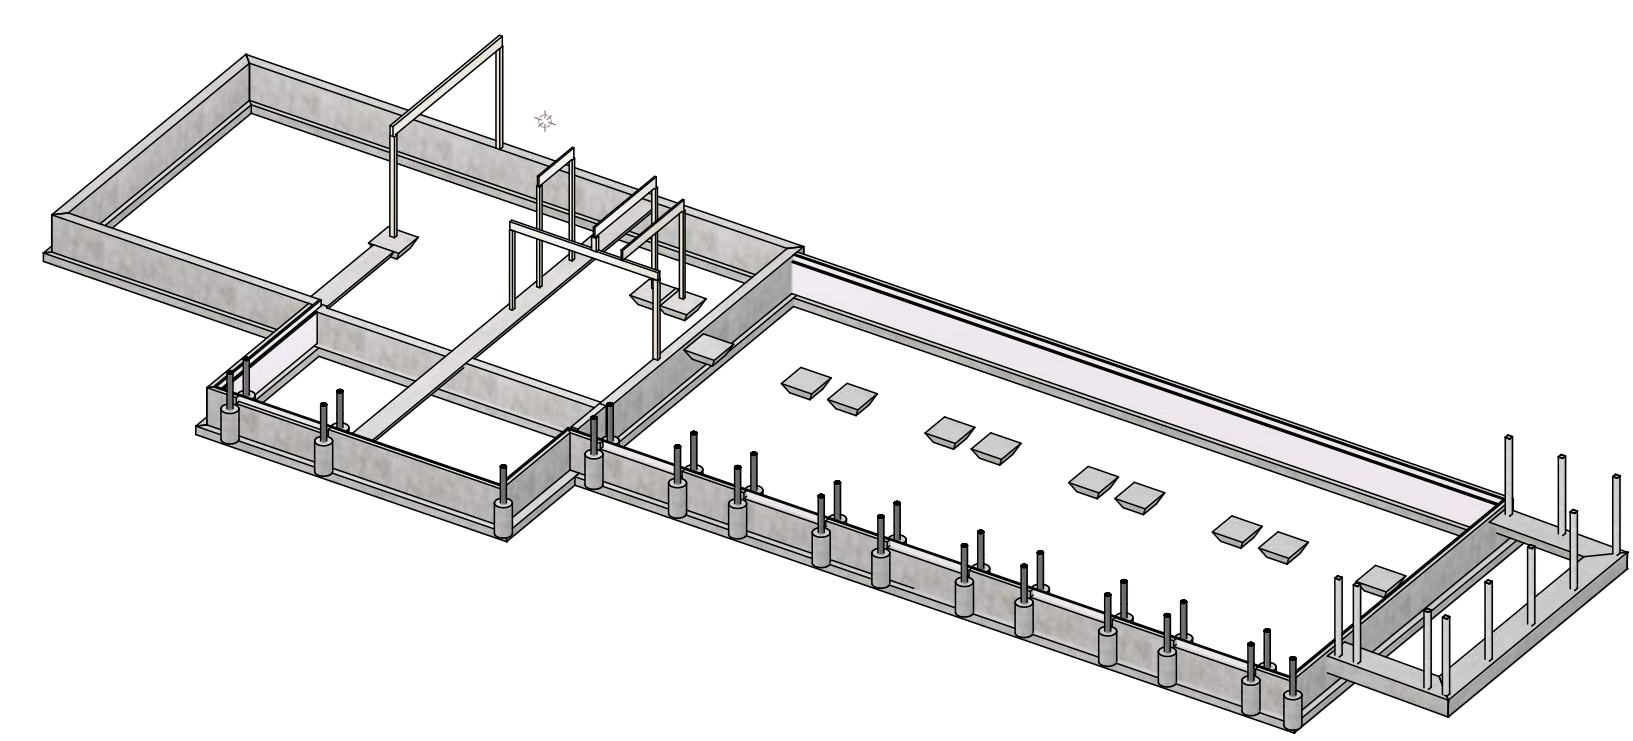

3A/S101 FOUNDATION - 3D - 2
1/16"=1'-0"

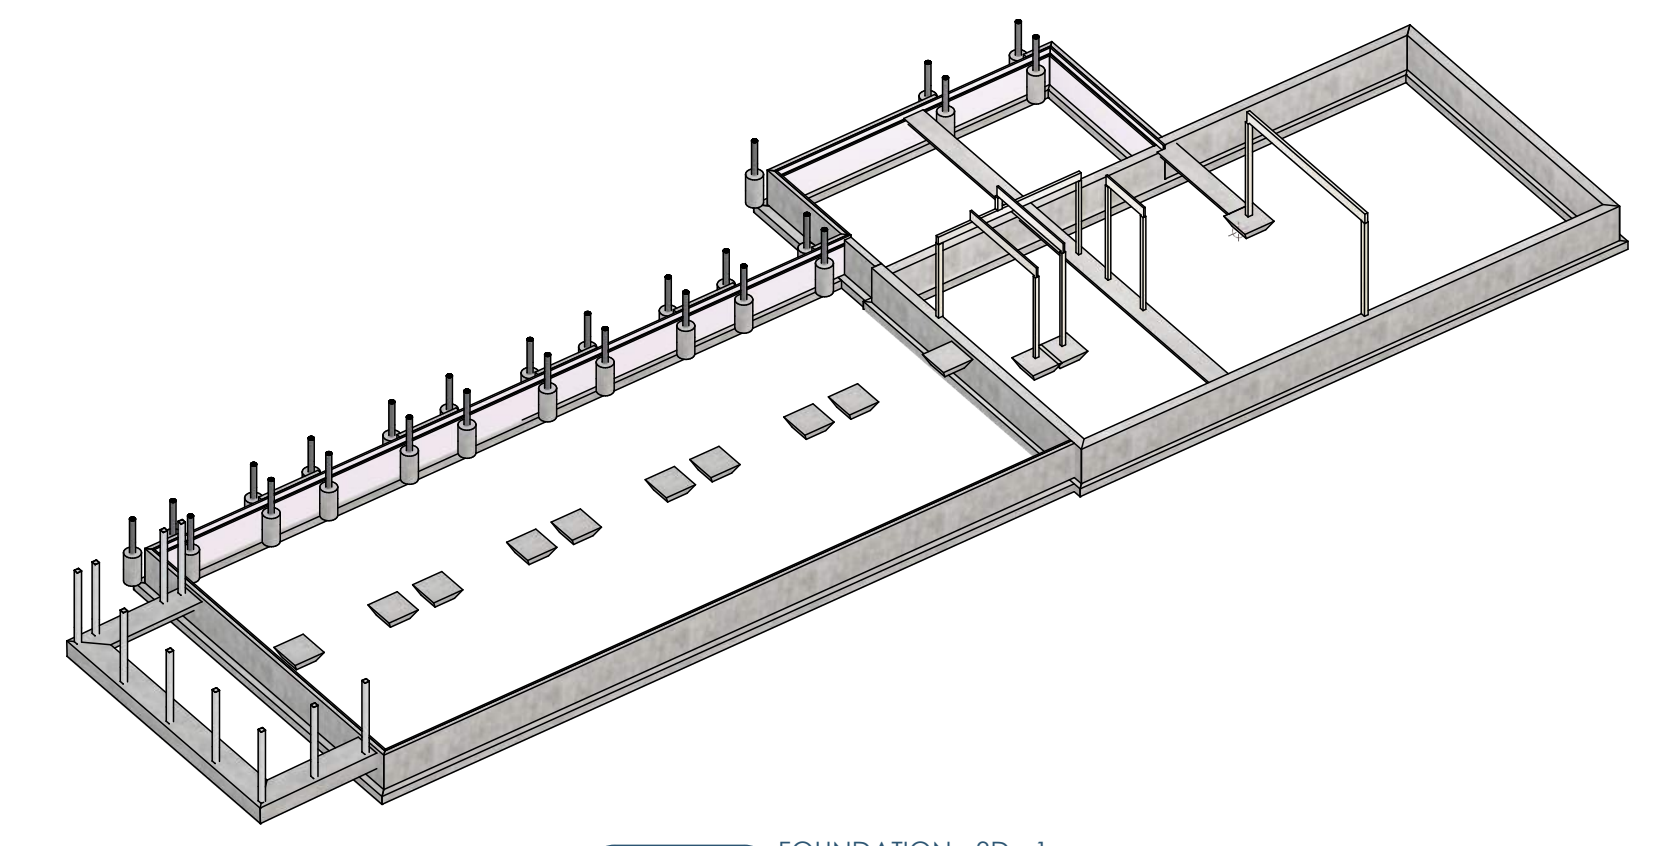

1A/S101 FOUNDATION - 3D - 1
1/16"=1'-0"




Owner: Cool Car Guys
1600 Center Ave
Janesville, WI 53546
608.531.1600

GC: Lake Country Construction Group
161 Horizon Dr
Verona, WI 53593
608.845.1398

Architect: Opening Design
17 S Fairchild | FL 7
Madison, WI 53703
ryan@openingdesign.com | 773.425.6456

This project, like most Opening Design's projects, is open source (Attribution-ShareAlike 4.0 International=CC BY-SA 4.0) - freely available to any party for future use, assuming the terms such as Attribution and ShareAlike are honored.

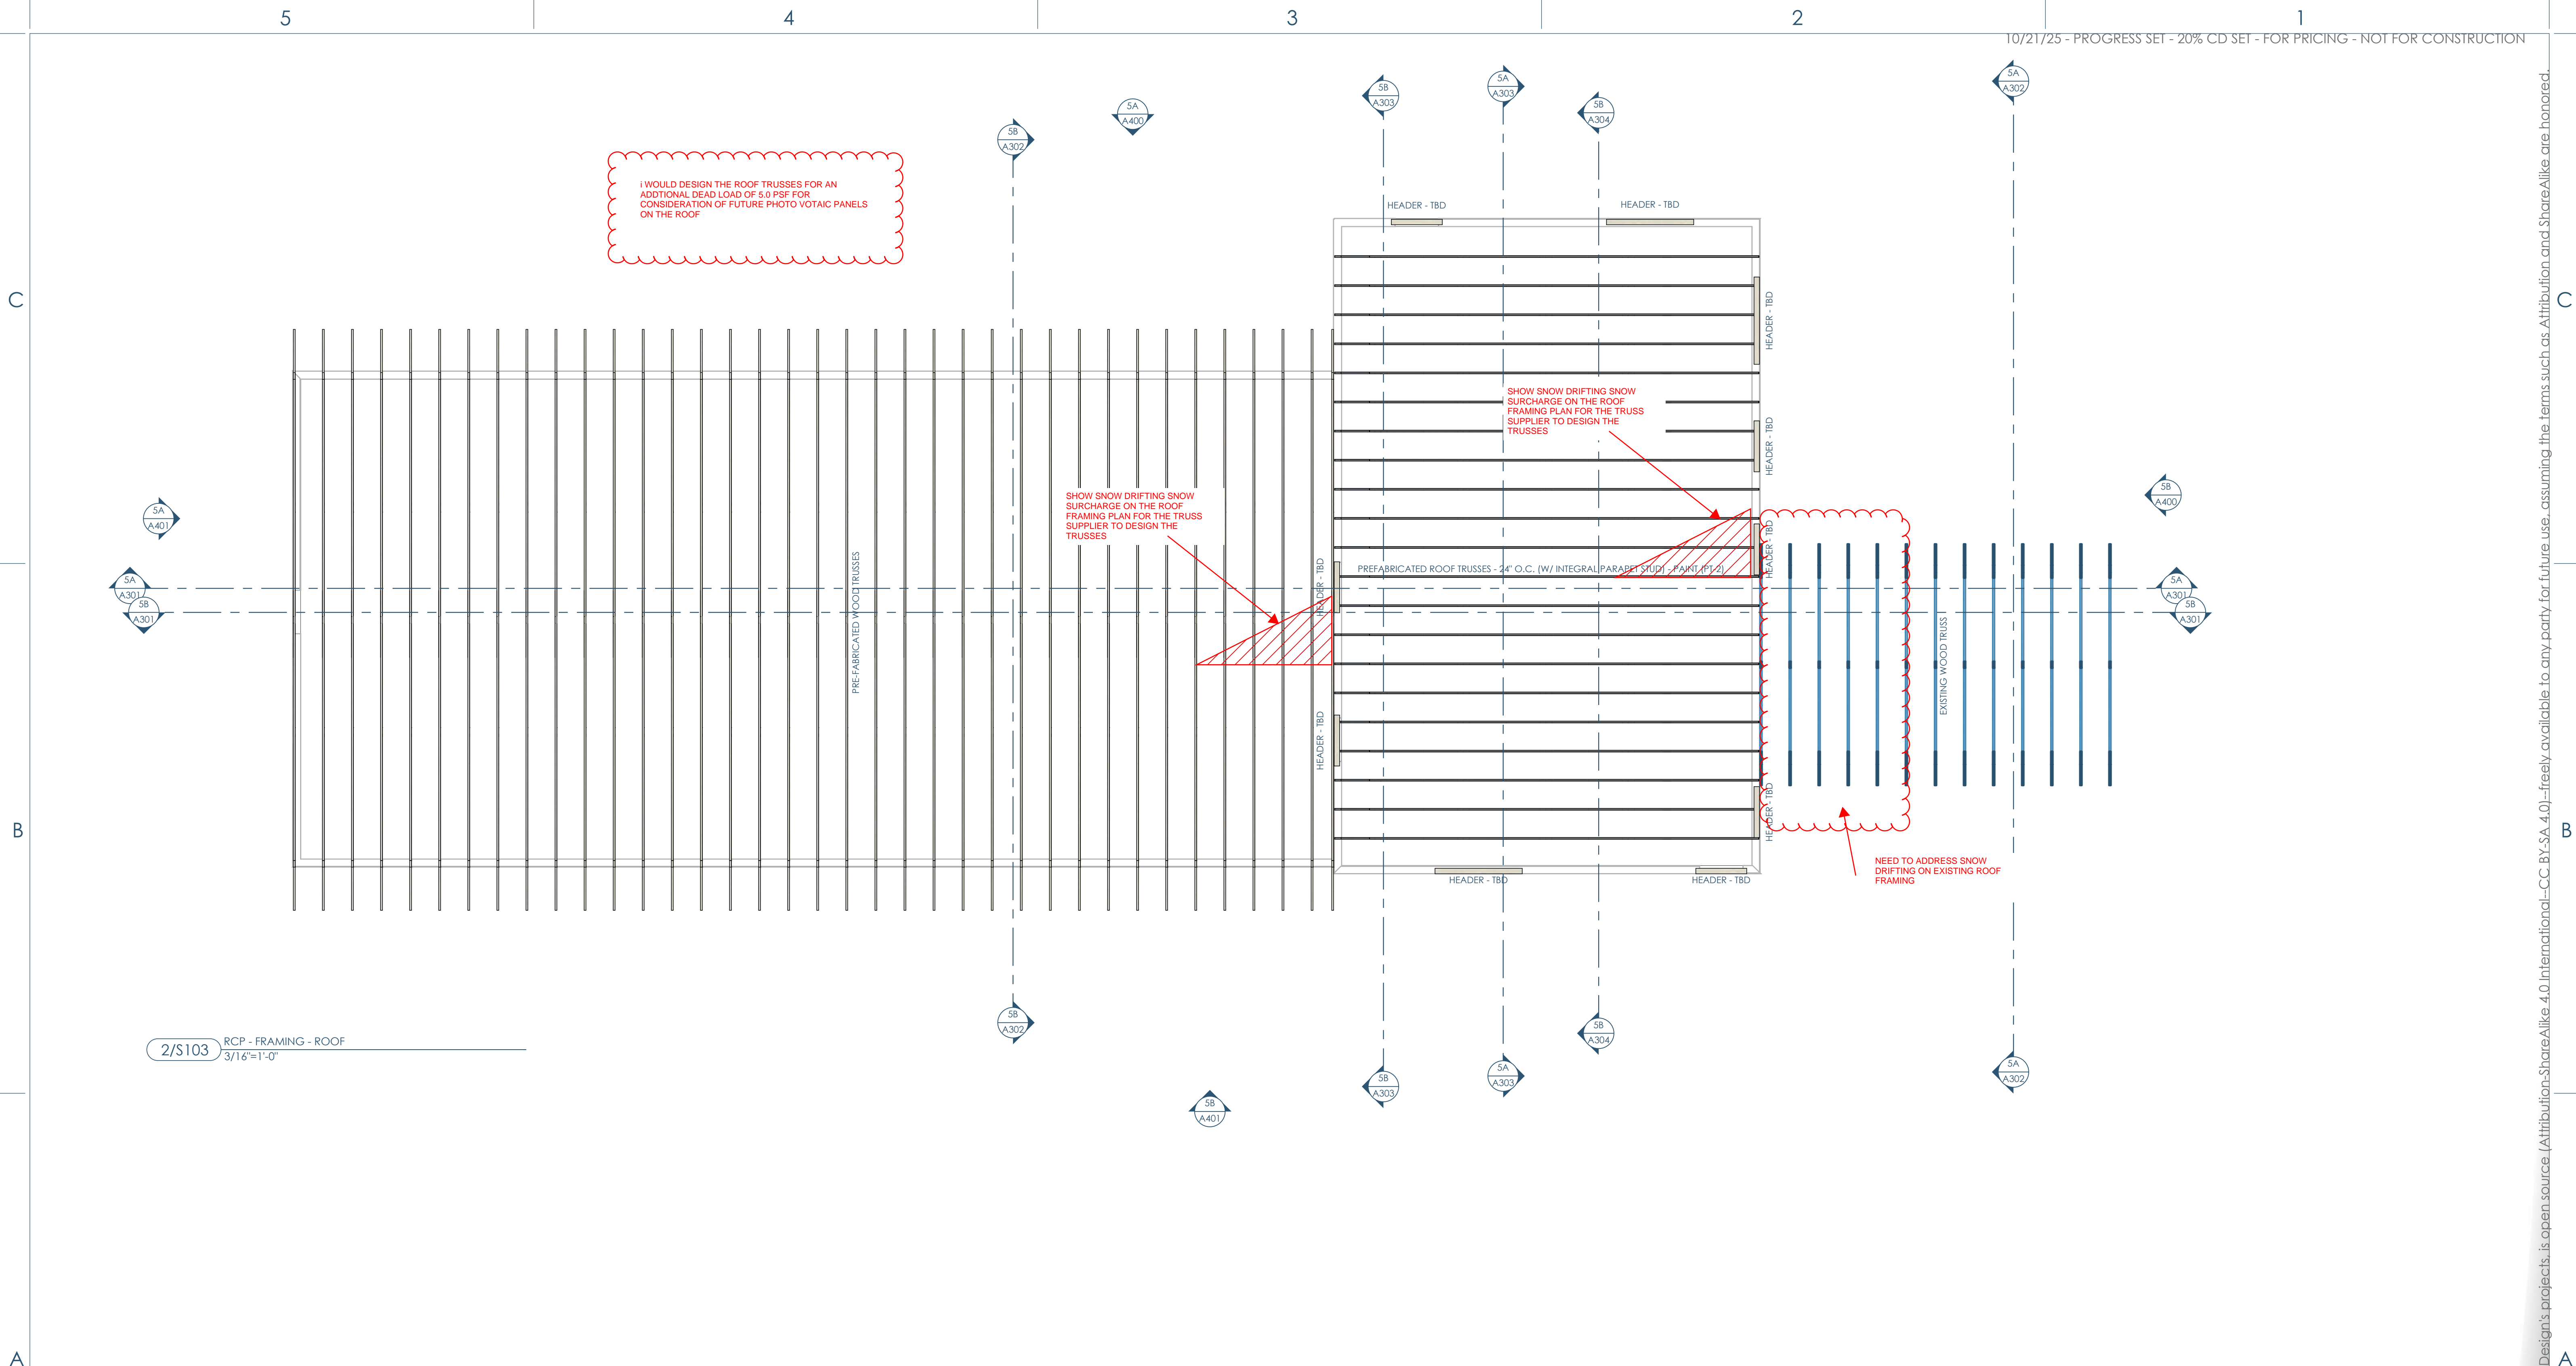

2/S103 RCP - FRAMING - ROOF
3/16"=1'-0"



Owner: Cool Car Guys
1600 Center Ave
Janesville, WI 53546
608.531.1600



GC: Lake Country Construction Group
161 Horizon Dr
Verona, WI 53593
608.845.1398



Architect: Opening Design
17 S Fairchild | FL 7
Madison, WI 53703
ryan@openingdesign.com | 773.425.6456

FRAMING - ROOF
COOL CAR GUYS

1600 CENTER AVE, JANESVILLE, WI 53546

S103

This project, like most Opening Design's projects, is open source (Attribution-ShareAlike 4.0 International=CC BY-SA 4.0)=freely available to any party for future use...assuming the terms such as Attribution and ShareAlike are honored.