



TOTAL SQ = 6556 SQF
 EXISTING DRIVEWAY & EXISTING PATHWAY = 1006 SQFT
 BUILDING AREA = 1284 SQFT
 TOTAL USED AREA = 1284 + 1006 = 2290 SQFT
 LOT COVERAGE = (2290 / 6556) = 35%




5A/A100 SITE PLAN
 1/8"=1'-0"

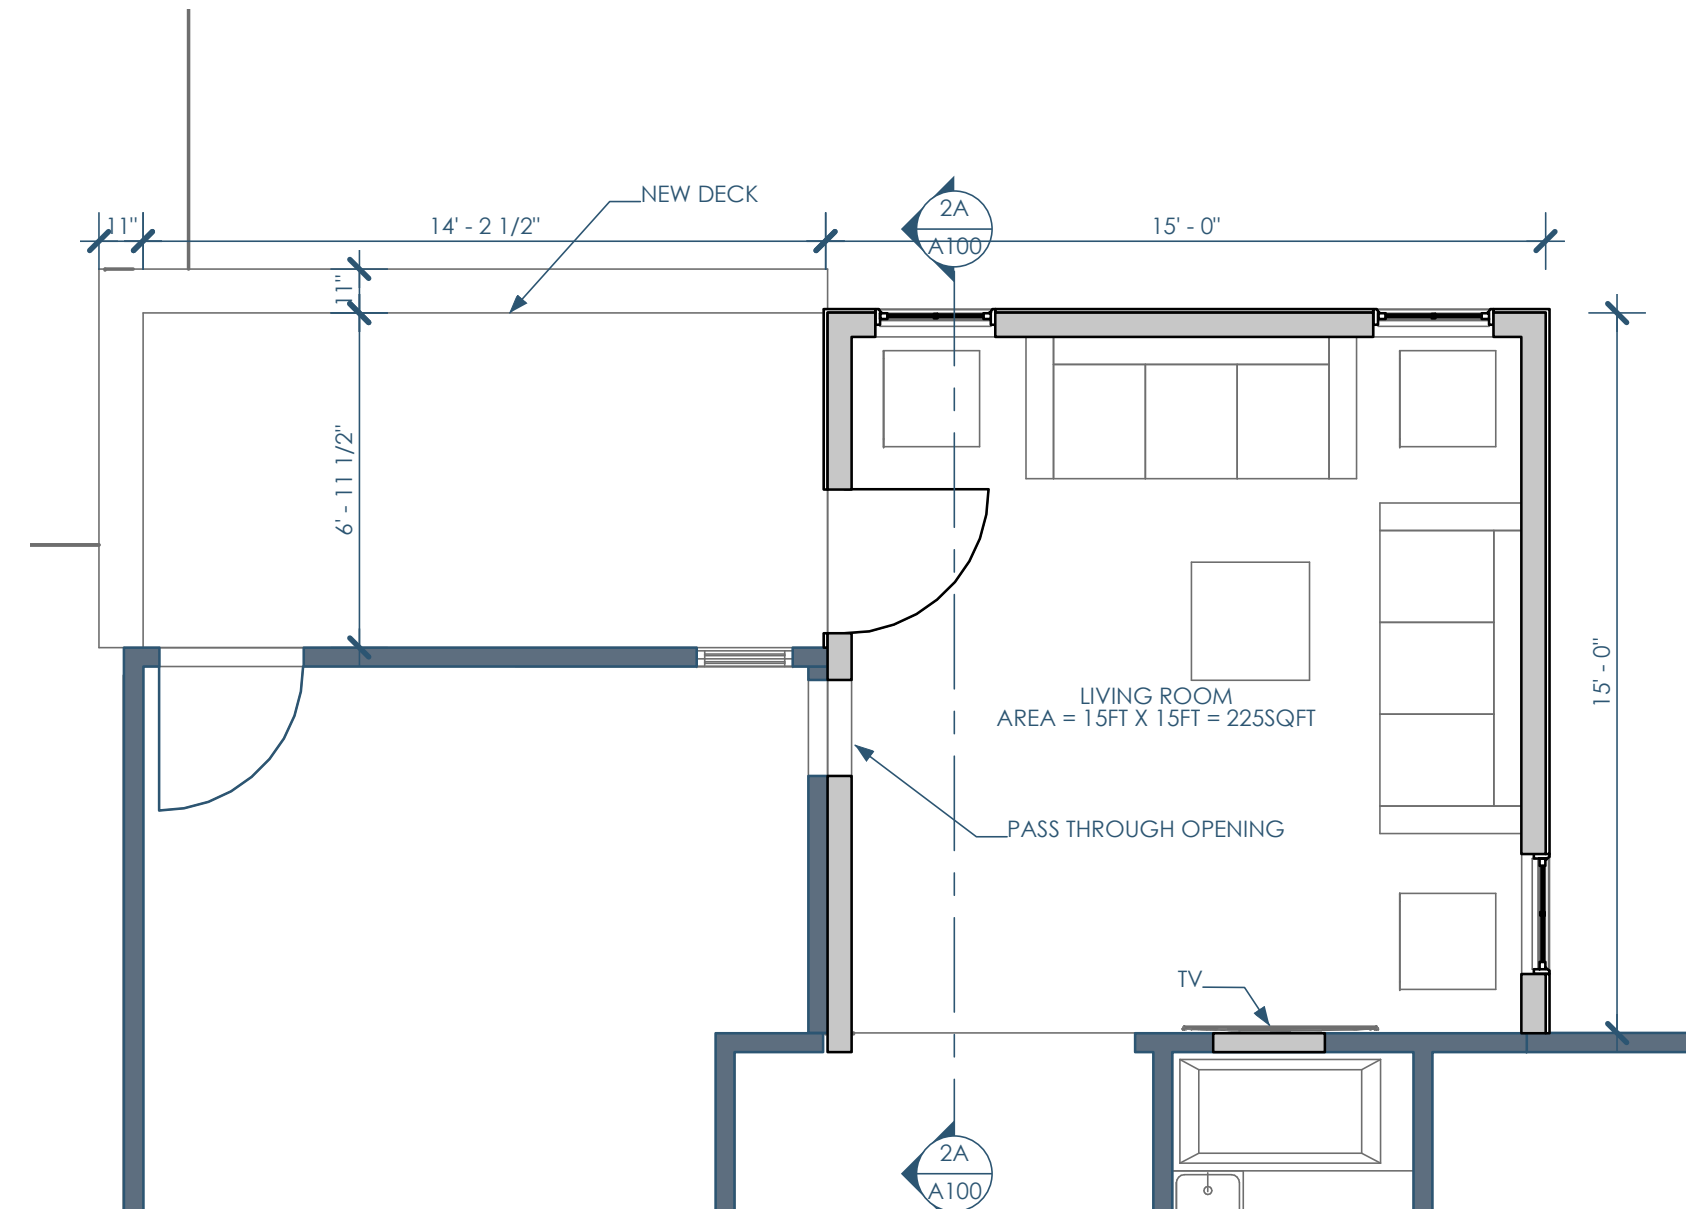


4C/A100 FLOOR PLAN
 1/4"=1'-0"

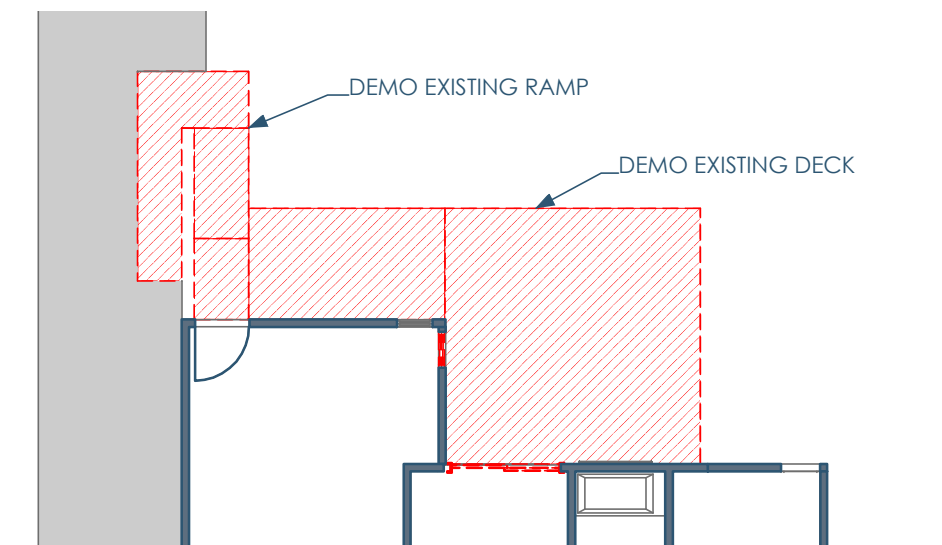

4B/A100 DEMO PLAN
 3/32"=1'-0"

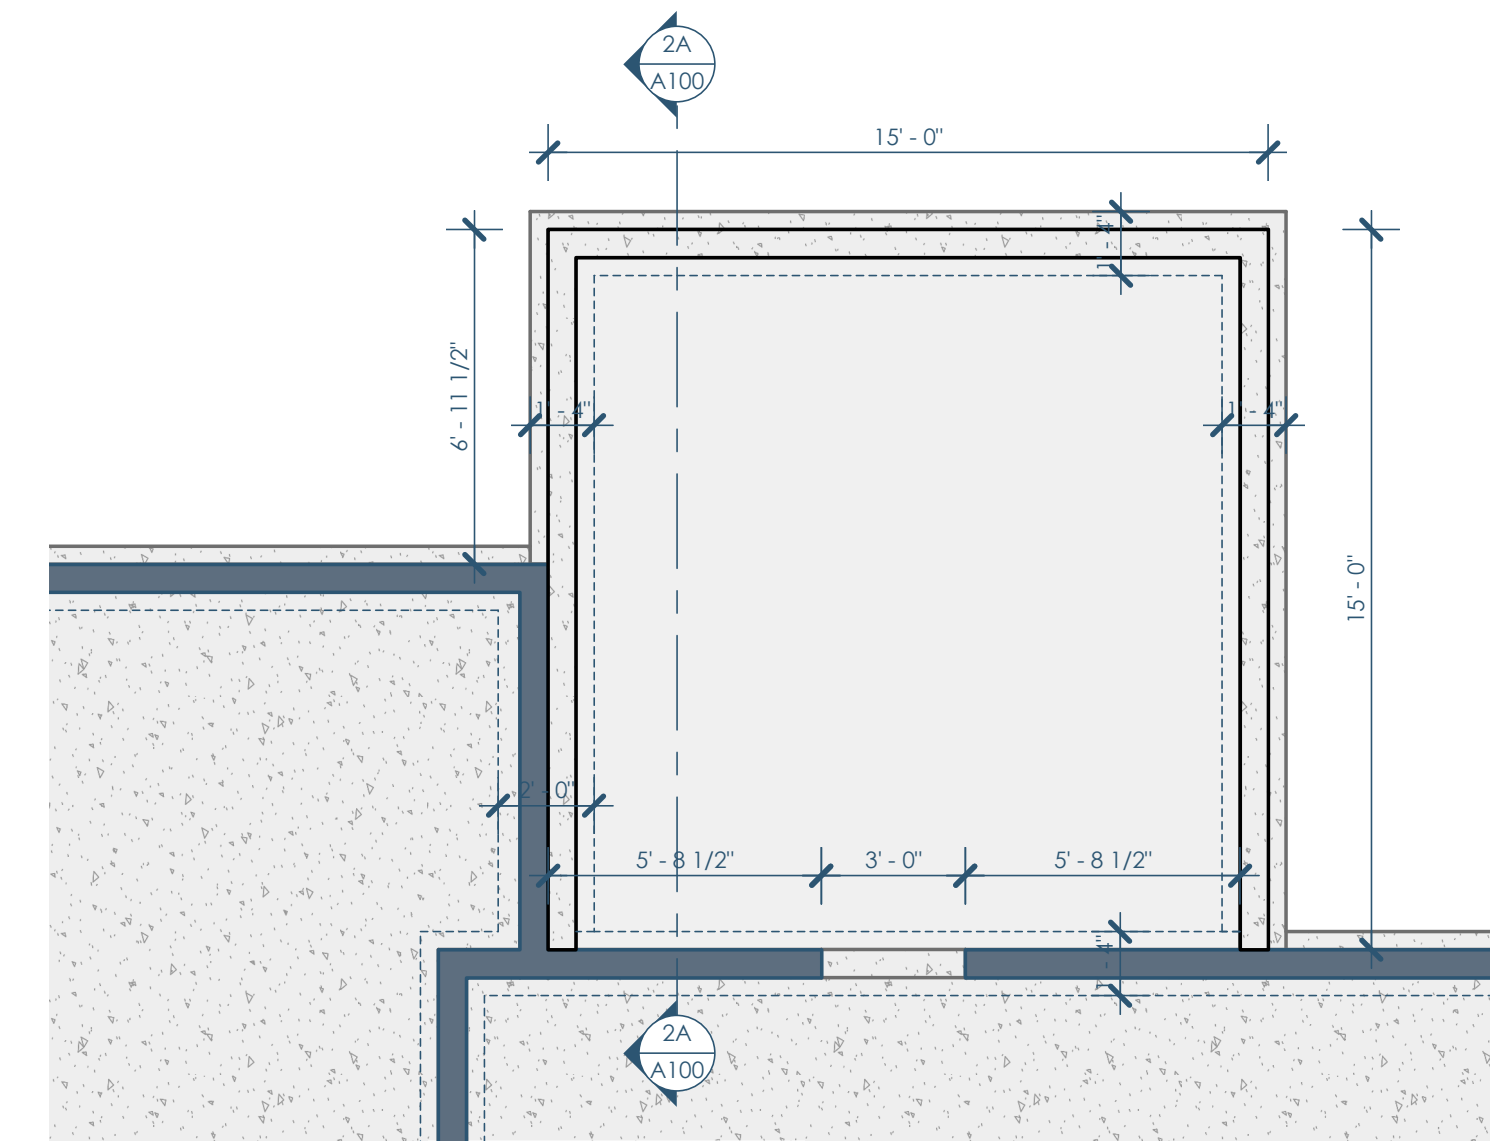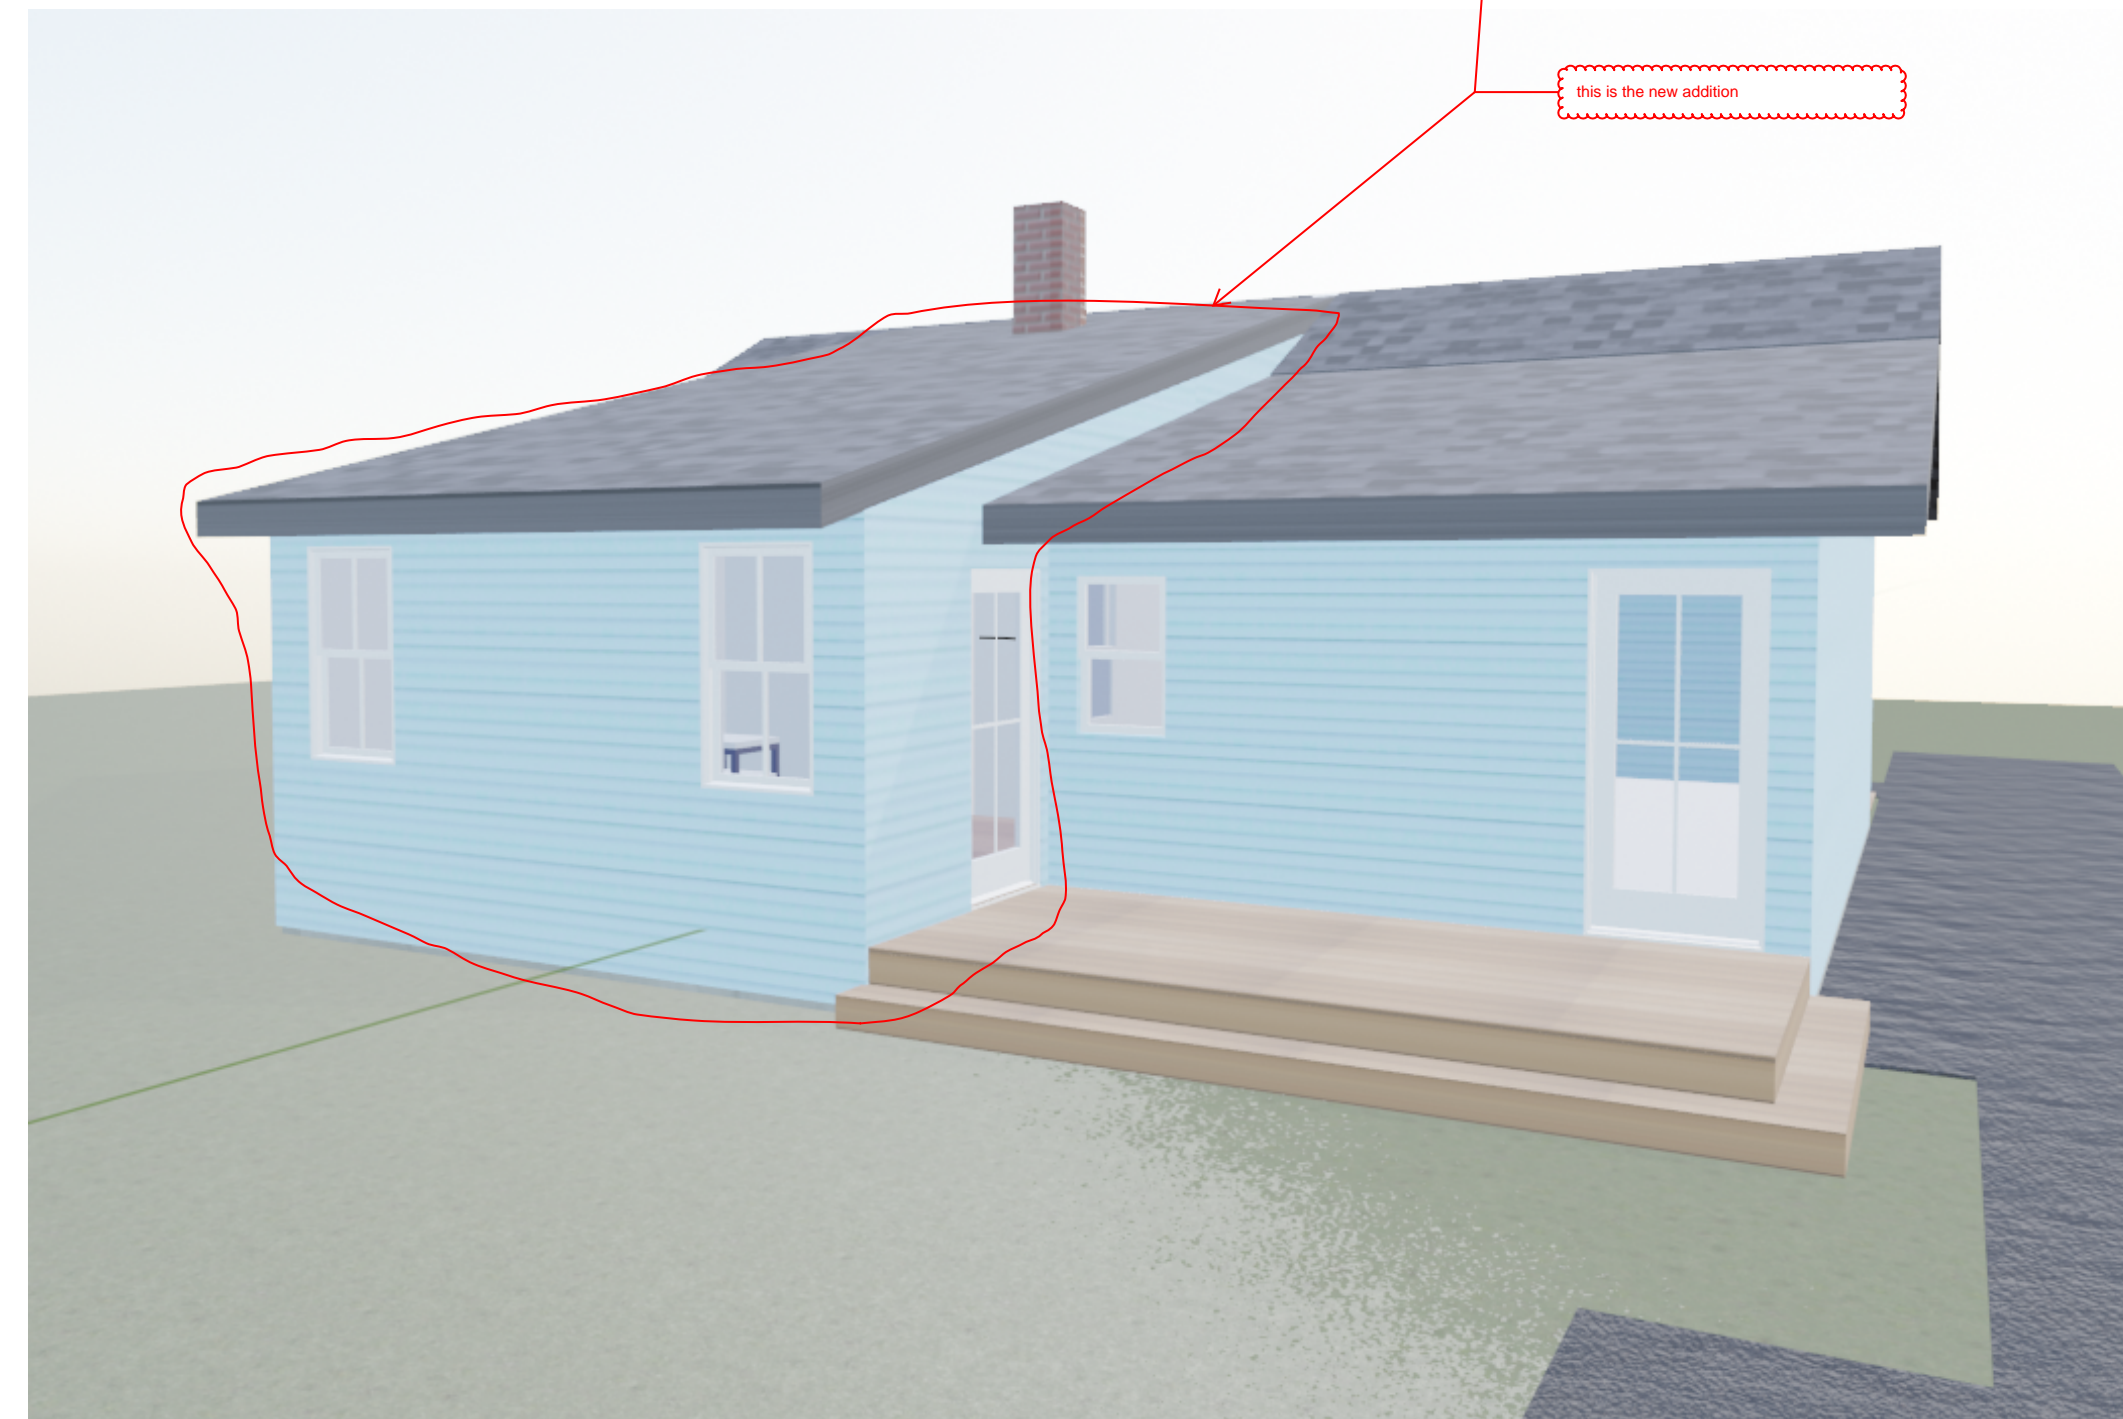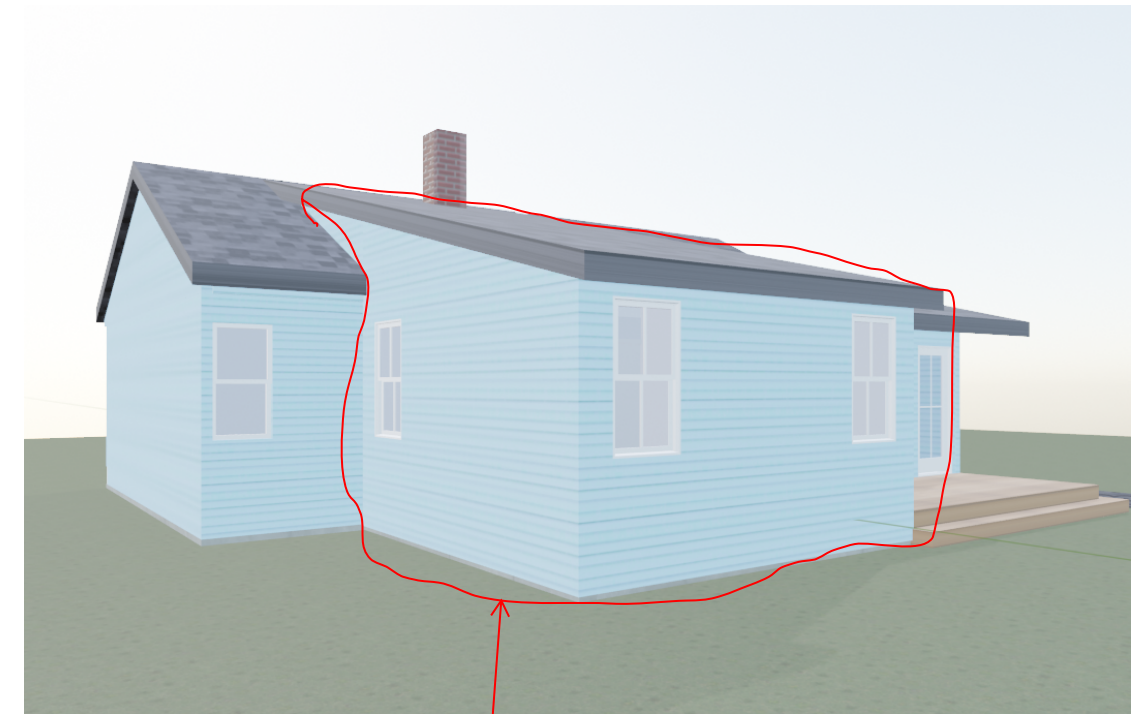

2C/A100 BASEMENT PLAN
 1/4"=1'-0"

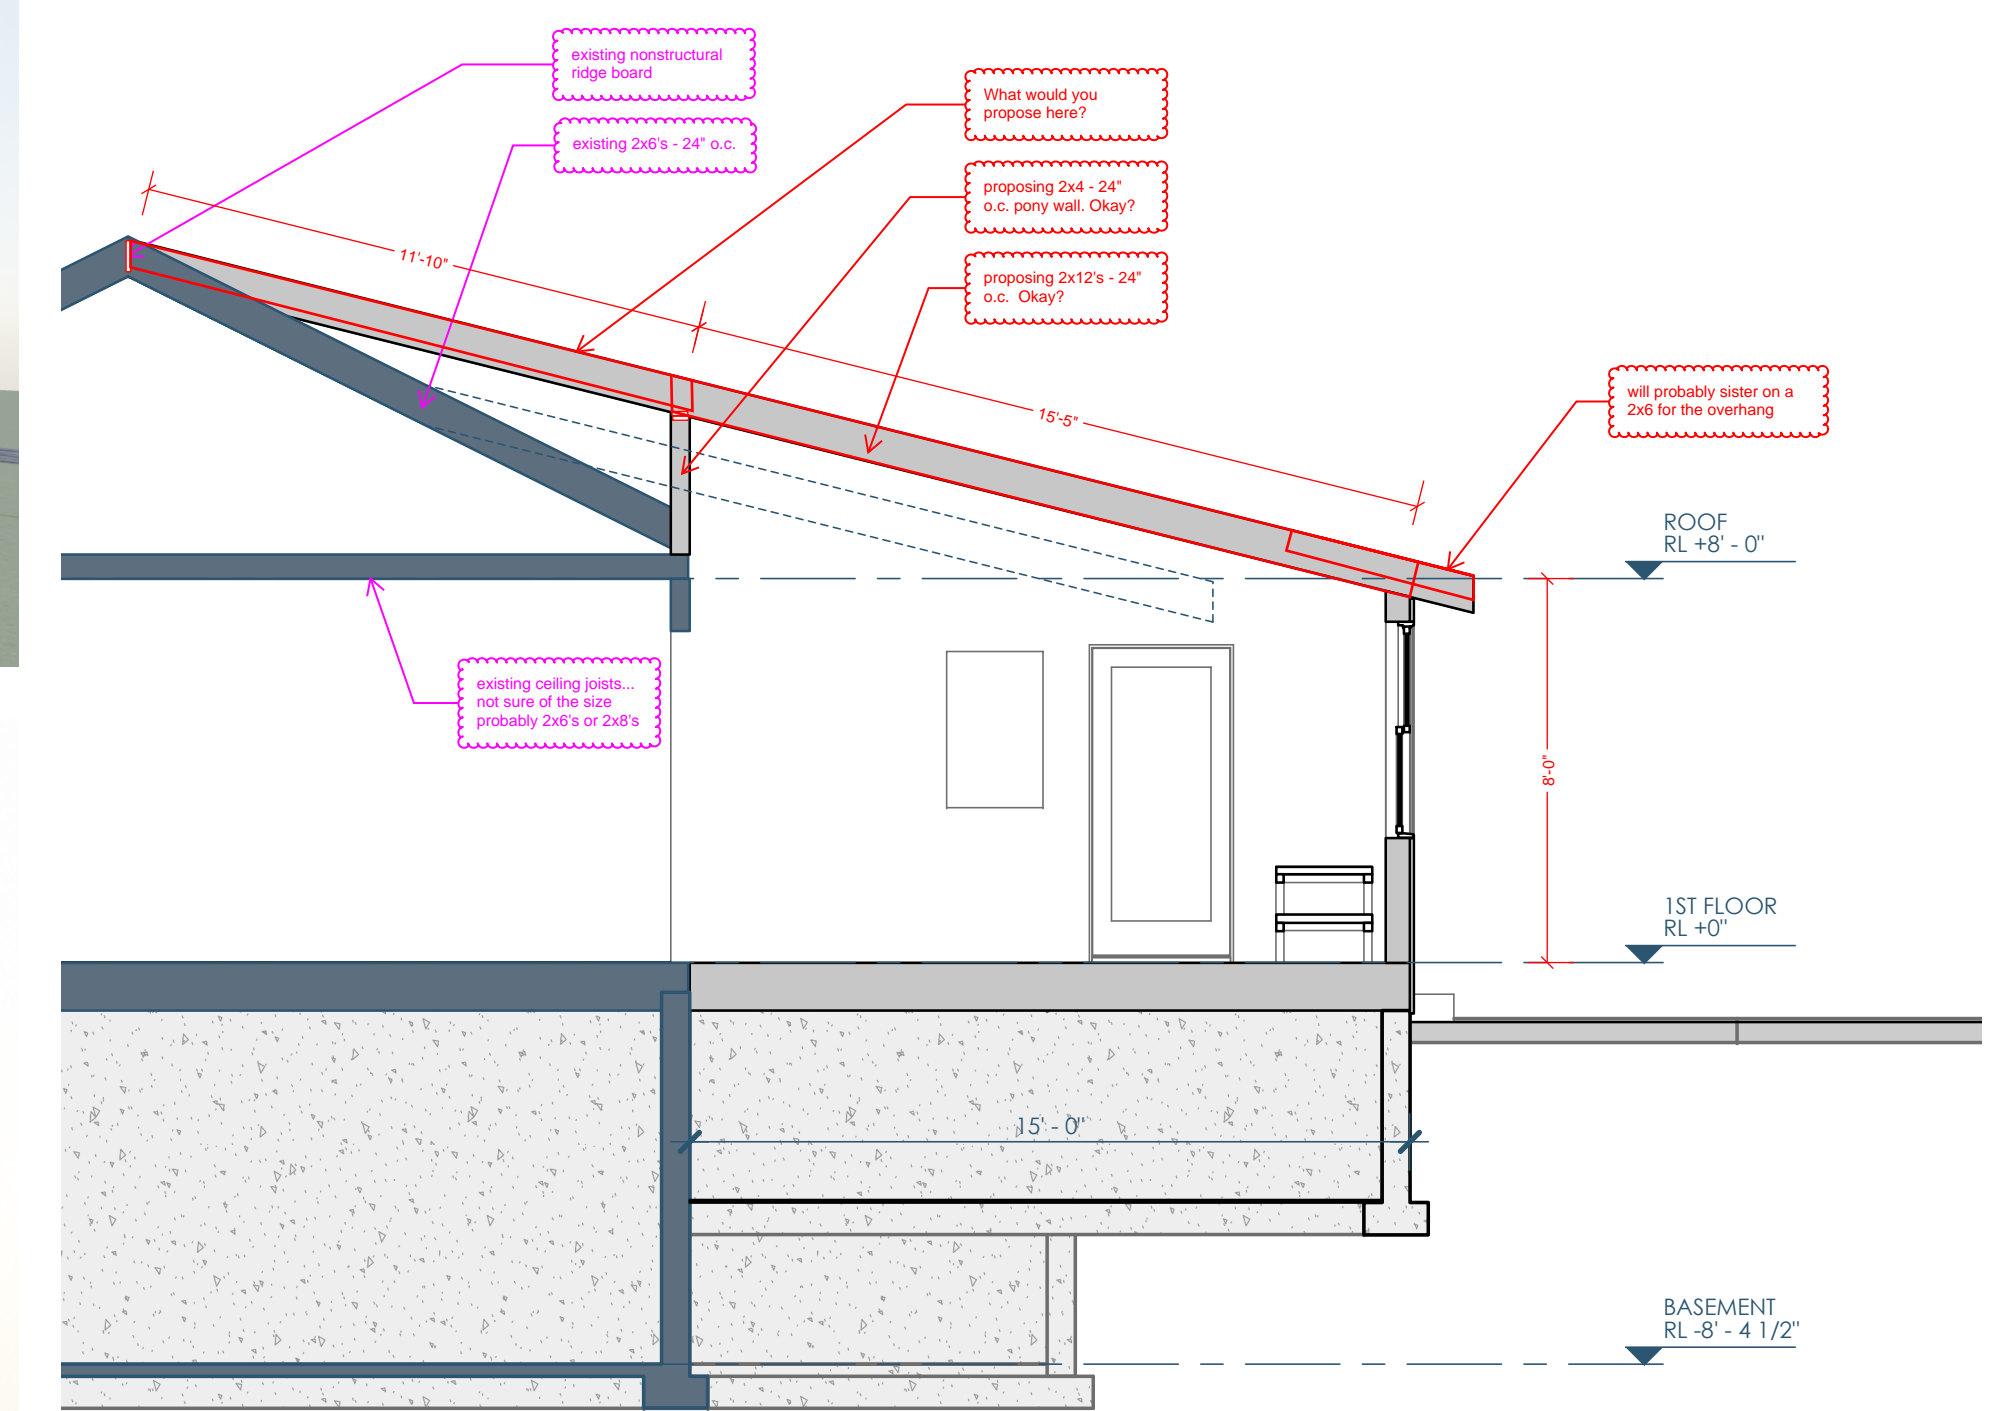

2A/A100 WEST SECTION
 1/4"=1'-0"



Architect: Opening Design
 17 S Fairchild | FL 7
 Madison, WI 53703
 ryan@openingdesign.com | 773.425.6456

GC: Exceptional Exteriors
 441 Glacier Moraine Dr | Unit 10
 Stoughton, WI, 52589
 exceptionalexteriors608@gmail.com | 608.354.6887

FLOOR PLAN OPTION_02/07/2024
 RESIDENTIAL EXTENSION
 1316 LOFTSGORDON AVE, MADISON, WI, 53704

A100